

SURVEY & REMONUMENTATION

\$7.00
\$2.00

SEP 03 1999

"other" code 14

SECTION LAND CORNER RECORDATION CERTIFICATE Filing Requirement of Act 74, Mich. P.A. 1970 KENT COUNTY REMONUMENTATION

For corners in

Kent
(County)

Located in: Grattan
Township

Corner Code #

1. Public Land Survey
T 8N R 9W
T R
T R Reference Monument
T R
2. Property Controlling
in Section S T R 1321.50' (Rec. Dist.)
S T R East of F-3
3. Miscellaneous
Property in Sec. S T R
S T R

4. Lot No. , Recorded Plat
5. Private Claims

I, Randy Kolehouse, in a field survey on March 13 19 98, do hereby certify that under requirements of P.A. 74 Michigan P.A. of 1970, the corner points mentioned in lines 1 and 2 above were in conformance with regulations and rules therefore as required in the current manual of survey instructions of the United States Department of the interior, Bureau of Land Management or by a decree of a Court of Law and/or that the corner points mentioned in lines 3, 4 and 5 above were in conformance with the rules of the Michigan Board of Land Surveyors or by a Decree of a Court of Law; established, re-established, monumented, re-monumented, recovered, found as expressed below:

NOTE: Not more than 4 corners, all in the same town and range, may be recorded on this certificate.

A. Description of original monument and accessories and/or subsequent restoration:

F-3	1837	G.L.O. Notes	Cathcart	Post in Lake
	1887 & 1913	Notes	Williams & Works	Post
	1956	Notes	Williams & Works	Iron Pipe
	1991	L.C.R.C. #5748	T. Chettleburgh	Fnd. Iron Pipe / Set K.C. Ref. Monument
	1995	L.C.R.C. #8026	Glaza & Associates	K.C. Ref. Monument
	1995	L.C.R.C. #8412	Glaza & Associates	K.C. Ref. Monument

P.A. 345 1990 KENT COUNTY

PEER APPROVED 6/25/98
CHAIRMAN Randy Kolehouse

This corner was originally approved by the Kent County Remonumentation Peer Group and monumented by T. Chettleburgh on 2/18/91 and was recorded per L.C.R.C. #5748.

B. Description of corner evidence found and/or method applied in restoring or reestablishing corner:

- F-3 Found a Standard Kent County Ref. Monument 2.5' West of the C/L of Lessiter Road (bit.) running North and South per L.C.R.C.'s #5748, #8026 and #8412 as set by T. Chettleburgh in place of an iron pipe he found 1321.54' West of G-3 which checked the 1887-1913 notes of Williams & Works.

L.C.R.C. #5748

KC Remon tag in top of S. guard rail post N 29° E 41.21'
KC Remon tag in W. side of power pole S 28° W 166.96'
KC Remon tag in top of S. guard rail post N 42° W 18.26'
KC Remon tag in W. side of power pole N 26° W 161.15'

L.C.R.C. #8412


KC remon tag top S guard rail post N 29° E 41.16' (m. 41.15')
KC remon tag W side Power Pole S 28° W 166.89' (m. 166.99')
KC remon tag top S guard rail post N 42° W 18.23' (m. 18.28')
KC remon tag W side Power Pole N 26° W 161.95' (m. 161.99')

The selected location is accepted by me and is generally accepted by professional surveyors as the best available evidence of the position of the original corner.

C. Description of monument for corner and accessories established to perpetuate locating the position of the corner:

- F-3 Standard Kent County Reference Monument

Nail & K.C. remon. tag on top of S guard rail post N 29° E 41.15'
Nail & K.C. remon. tag on W side P. pole S 28° W 166.94'
Nail & K.C. remon. tag on top of S guard rail post N 42° W 18.28'
Nail & K.C. remon. tag on W side P. pole N 26° W 161.99'
C/L of bit. road running N-S, East 2.5'

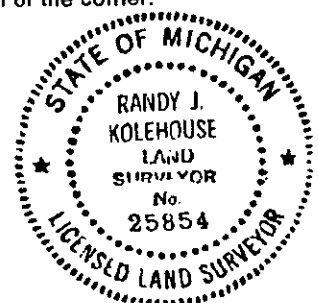

Signed by Randy J. Kolehouse
EARTH TECH

Date 12/5/98

Surveyor's Michigan License No. 25854