

FEB 14 1997

KENT COUNTY REMONUMENTATION

COMMISSION

LAND CORNER RECORDATION CERTIFICATE

Filing Requirement of Act 74, Mich. P.A. 1970

For corners in
KENT COUNTY
(County)

Located In:

Corner Code #

1. Public Land Survey

T _____ R _____

T _____ R _____

T _____ R _____

T _____ R _____

2. Property Controlling
in Section

S 29 T 8N R 11W

S _____ T _____ R _____

3. Miscellaneous

S _____ T _____ R _____

Property in Section

S _____ T _____ R _____

#2

Wit. Mon. on

E-W 1/4 line

Sec. 29

REC. OF DEEDS

Lucy Bond

96 MAR 20 AM 8:55

STATE OF MICHIGAN
COUNTY OF KENT
RECEIVED FOR RECORD

9048

Register of Deeds Stamp & File Number

4. Lot No. _____, Recorded Plat _____

5. Private Claims _____

I, Kirk Breitels, in a field survey on Jan. 26, 19 96

do hereby certify that under requirements of P.A. 74, Michigan P.A. of 1970, the corner points mentioned in lines 1 and 2 above were in conformance with regulations and rules therefore as required in the current manual of survey instructions of the United States Department of the Interior, Bureau of Land Management or by a decree of a Court of Law and/or that the corner points mentioned in lines 3, 4 and 5 above were in conformance with the rules of the Michigan Board of Professional Surveyors or by a Decree of a Court of Law; established, re-established, monumented, re-monumented, recovered, found as expressed below:

NOTE: Not more than 4 corners, all in the same town and range, may be recorded on this certificate.

A. Description of original monument and accessories and/or subsequent restoration:

1837

GLO

Not set

1992

LCRC #6647

Marschall

Set Kent County Witness Monument on E-W 1/4 line
302.00' East of the C 1/4 corner of Sec. 29.

The position of this corner was previously approved by the Kent County Remonumentation Peer Group, monumented (Witness Monument) by Chris Marschall on 11/2/92 and was recorded per LCRC #6647.

B. Description of corner evidence found and/or method applied in restoring or reestablishing corner:

Found Standard Kent County Witness Monument per witnesses from above LCRC as set by Chris Marschall.

LCRC #6647

Nail & KC Remon. tag W. side 12" Ash N30°W 6.82'

Nail & KC Remon. tag S. side 12" Ash N85°E 26.46'

Nail & KC Remon. tag NW side 32" Oak N60°E 20.63'

N. edge of plowed field is South 10'±

Angle point of plowed field is West 50'±

P.A. 345 1990 KENT COUNTY

PEER APPROVED 3/7/96

CHAIRMAN *Harry Huber*

The selected location is accepted by me and is generally accepted by professional surveyors as the best available location of the corner.

C. Description of monument for corner and accessories established to perpetuate locating the position of the corner:

Standard Kent Co. Witness Monument

Nail & KC Remon. tag W. side 12" Ash N30°W 6.82'


Nail & KC Remon. tag S. side 12" Ash N85°E 26.46'

Nail & KC Remon. tag NW side 32" Oak N60°E 20.63'

Set Nail & KC Remon. tag E. side Tri. 18" Oak N15°E 32.69'

N. edge of plowed field is South 10'±

Angle point of plowed field is West 50'±

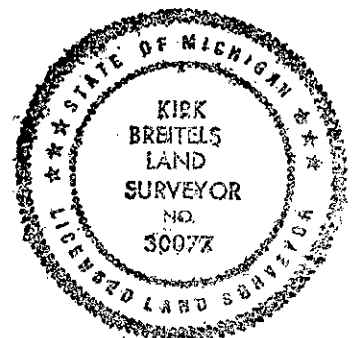

Signed by

Kirk Breitels

Date

2/6/96

Surveyor's Michigan License No. 30077

FORM APPROVED BY MICHIGAN STATE BOARD OF PROFESSIONAL SURVEYORS, JAN. 28, 1971
REVISED MAY 14, 1975
REVISED JAN., 1983