

FEB 14 1997

COMMISSION

KENT COUNTY REMONUMENTATION

LAND CORNER RECORDATION CERTIFICATE

Filing Requirement of Act 74, Mich. P.A. 1970

For corners in
KENT COUNTY
(County)

Located In:

Corner Code #

1. Public Land Survey T _____ R _____
T _____ R _____
T _____ R _____
T _____ R _____
2. Property Controlling S 22 T 8N R 11W
in Section S _____ T _____ R _____
3. Miscellaneous S _____ T _____ R _____
Property in Section S _____ T _____ R _____

#6
Wit. Mon. on
N-S 1/4 line
Sec. 22

STATE OF MICHIGAN
COUNTY OF KENT
RECEIVED FOR RECORD
96 JUN -7 AM 8:29
REG. OF DEEDS
9190

Register of Deeds Stamp & File Number

4. Lot No. _____, Recorded Plat _____
5. Private Claims _____

I, **Kirk Breitels**, in a field survey on **Jan. 26**, 19 **96**,
do hereby certify that under requirements of P.A. 74, Michigan P.A. of 1970, the corner points mentioned
in lines 1 and 2 above were in conformance with regulations and rules therefore as required in the current
manual of survey instructions of the United States Department of the Interior, Bureau of Land
Management or by a decree of a Court of Law and/or that the corner points mentioned in lines 3, 4 and
5 above were in conformance with the rules of the Michigan Board of Professional Surveyors or by a
Decree of a Court of Law; established, re-established, monumented, re-monumented, recovered, found
as expressed below:

NOTE: Not more than 4 corners, all in the same town and range, may be recorded
on this certificate.

A. Description of original monument and accessories and/or subsequent restoration:

1837 GLO Not set
1992 LCRC #6579 Marschall Set Kent County Witness Monument on
N-S 1/4 line of Sec. 29.

The position of this corner was previously approved by the Kent County Remonumentation
Peer Group, monumented (Witness Monument) by Chris Marschall on 10/9/92 and was recorded
per LCRC #6579.

B. Description of corner evidence found and/or method applied in restoring or reestablishing corner:

Found Standard Kent County Witness Monument per witnesses from above LCRC as set by
Chris Marschall.

LCRC #6579

Nail & KC Remon. tag W. side 30" Ash S01°E 9.05'
Centerline 3" steel irrigation stand pipe N77°W 75.43'
Nail & KC Remon. tag SW side P. Pole N40°W 49.90'
Nail & KC Remon. tag W. side 12" Ash N30°E 64.77'
NW corner of Boat Hse. (siding) N50°E 48.56'
SW corner of Hse. (Conc. Block) S79°E 46.93'

Top of River Bank - South 5'± Edge of River - South 35'±

The selected location is accepted by me and is generally accepted by professional
surveyors as the best available location of the corner.


P.A. 345 1990 KENT COUNTY

PEER APPROVED 5/30/96
CHAIRMAN *Harry Huber*

C. Description of monument for corner and accessories established to perpetuate locating the position of the corner:

Standard Kent Co. Witness Monument

Nail & KC Remon. tag W. side 32" Ash S01°E 9.05'
Centerline 3" steel irrigation stand pipe N77°W 75.43'
Nail & KC Remon. tag SW side P. Pole N40°W 49.92'
New Nail & KC Remon. tag W. side 14" Ash N30°E 64.79'
NW corner of Boat Hse. (siding) N50°E 48.56'
SW corner of Hse. (Conc. Block) S79°E 46.98'
Top of River Bank (S. edge of lawn) - South 5'±
Edge of River - South 35'±

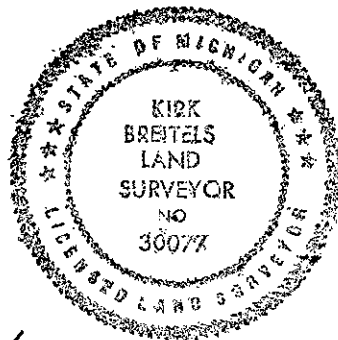

Signed by *Kirk Breitels*

Date 2/6/96

Surveyor's Michigan License No. 30077