

SURVEY & REMONUMENTATION

KENT COUNTY REMONUMENTATION

FEB 14 1997

LAND CORNER RECORDATION CERTIFICATE

Filing Requirement of Act 74, Mich. P.A. 1970

For corners in
KENT COUNTY
(County)

Located In:

Corner Code #

1. Public Land Survey

T R

T R

T R

2. Property Controlling
in Section

S 24 T 8N R 11W

S T R

3. Miscellaneous

S T R

Property in Section

S T R

Wit. Mon. on
S. line Sec. 24

9110

Register of Deeds Stamp & File Number

REG. OF DEEDS

36 MAR 20 AM 8:59

STATE OF MICHIGAN
COUNTY OF KENT
RECEIVED FOR RECORD

4. Lot No. , Recorded Plat

5. Private Claims

I, **Kirk Breitels**, in a field survey on **Jan. 25**, 19 **96**

do hereby certify that under requirements of P.A. 74, Michigan P.A. of 1970, the corner points mentioned in lines 1 and 2 above were in conformance with regulations and rules therefore as required in the current manual of survey instructions of the United States Department of the Interior, Bureau of Land Management or by a decree of a Court of Law and/or that the corner points mentioned in lines 3, 4 and 5 above were in conformance with the rules of the Michigan Board of Professional Surveyors or by a Decree of a Court of Law; established, re-established, monumented, re-monumented, recovered, found as expressed below:

NOTE: Not more than 4 corners, all in the same town and range, may be recorded on this certificate.

A. Description of original monument and accessories and/or subsequent restoration:

1837	GLO	Whitcomb	Set Meander Post 30.70' chains West of the S 1/4 corner of Sec. 24
	Survey	Exxel Eng.	Set Property Iron on S. line Sec. 24
1992	LCRC #6618	Marschall	Set Kent County Witness Monument on S. line of Sec. 24.

The position of this corner was previously approved by the Kent County Remonumentation Peer Group, monumented (Witness Monument) by Chris Marschall on 8/4/92 and was recorded per LCRC #6618.

B. Description of corner evidence found and/or method applied in restoring or reestablishing corner:

Found Standard Kent County Witness Monument per witnesses from above LCRC as set by Chris Marschall in place of the Exxel Iron he found.

LCRC #6618

Nail & KC Remon. tag W. side 20" Hackberry

Nail & KC Remon. tag N. side 6" Basswood

Nail & KC Remon. tag NW side 8" Ash

Nail & KC Remon. tag NW side 8" Hackberry

Nail & KC Remon. tag N. side 8" Oak

Nail & KC Remon. tag N. side 8" Honey Locust

River SW - 15'±

S30°E 9.83'

N80°E 20.45'

N45°E 41.32'

N20°E 64.73'

S75°W 11.60'

N60°W 29.76'

P.A. 345 1990 KENT COUNTY

PEER APPROVED 3/7/96
CHAIRMAN *[Signature]*

The selected location is accepted by me and is generally accepted by professional surveyors as the best available location of the corner.

C. Description of monument for corner and accessories established to perpetuate locating the position of the corner:

Standard Kent Co. Witness Monument

New Nail & KC Remon. tag W. side 22" Hackberry

Nail & KC Remon. tag N. side 7" Basswood

Nail & KC Remon. tag NW side 9" Ash

New Nail & KC Remon. tag NW side 10" Hackberry

Nail & KC Remon. tag N. side 8" Oak

Nail & KC Remon. tag N. side 8" Honey Locust

River SW - 15'±

S30°E 9.86'


S80°E 20.47'

N45°E 41.35'

N20°E 64.76'

S75°W 11.54'

N60°W 29.81'

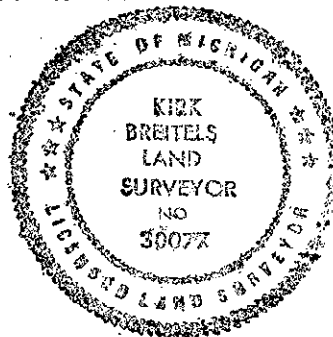

Signed by

[Signature]

Date

2/6/96

Surveyor's Michigan License No.

30077

FORM APPROVED BY MICHIGAN STATE BOARD OF PROFESSIONAL SURVEYORS, JAN. 23, 1971
REVISED MAY 14, 1975
REVISED JAN., 1983