

KENT COUNTY REMONUMENTATION
LAND CORNER RECORDATION CERTIFICATE
Filing Requirement of Act 74, Mich. P.A. 1970

For corners in

Kent
(County)

Oakfield Township
Located In: Corner Code 77

1. Public Land Survey

T _____ R _____
T _____ R _____
T _____ R _____

Other Code

2. Property Controlling
in Section

S 27 T 9N R 9W

Witness corner

3. Miscellaneous
Property in Sec.

S _____ T _____ R _____
S _____ T _____ R _____
S _____ T _____ R _____

to center of
Section 27

6821A
Register of Deeds Stamp & File Number

4. Lot No. _____, Recorded Plat _____

5. Private Claims _____

I, Chris Marschall, in a field survey on June 11, 19 93

do hereby certify that under requirements of P.A. 74, Michigan P.A. of 1970, the corner points mentioned in lines 1 and 2 above were in conformance with regulations and rules therefore as required in the current manual of survey instructions of the United States Department of the Interior, Bureau of Land Management or by a decree of a Court of Law and/or that the corner points mentioned in lines 3, 4 and 5 above were in conformance with the rules of the Michigan Board of Land Surveyors or by a Decree of a Court of Law, established, re-established, monumented, re-monumented, recovered, found as expressed below:

NOTE: Not more than 4 corners, all in the same town and range, may be recorded on this certificate.

A. Description of original monument and accessories and/or subsequent restoration

None

B. Description of corner evidence found and/or method applied in restoring or reestablishing corner:

Established the location of the Center of Section 27 by running the line from the N 1/4 corner to the S 1/4 corner and intersecting it with a line extending West from the E 1/4 corner on a mean Azimuth of the E 1/2 of the North line and the E 1/2 of the South line of Section 27. See other side for sketch.

C. Description of monument for corner and accessories established to perpetuate locating the position of the corner:

Set 30" Harrison Monument With Witness cap on the E & W 1/4 line.
122.00' S89°49'54" W of the Center of Section

Centerline 18' N & S Gravel Road

West 12'

Centerline 20' E & W Gravel Road

South 39'

Top center of a MBT Box

S05° W 57.30'

Nail & Tag E sd 8" Ash (4' above grd.)

S05° E 72.09'

Nail & Tag SW sd P.P.

S31° E 22.30'

Witness Mon. 30' South of Center of Section on N-S 1/4 line S76°20'18"E 125.49'

Signed by Chris Marschall


Date June 14, 1993

Surveyor's Michigan License No. 18661

See other side

6821 B

SECTION 27 AND 28, 19N, R9W,
 OAKFIELD TOWNSHIP, KENT COUNTY
 MICHIGAN

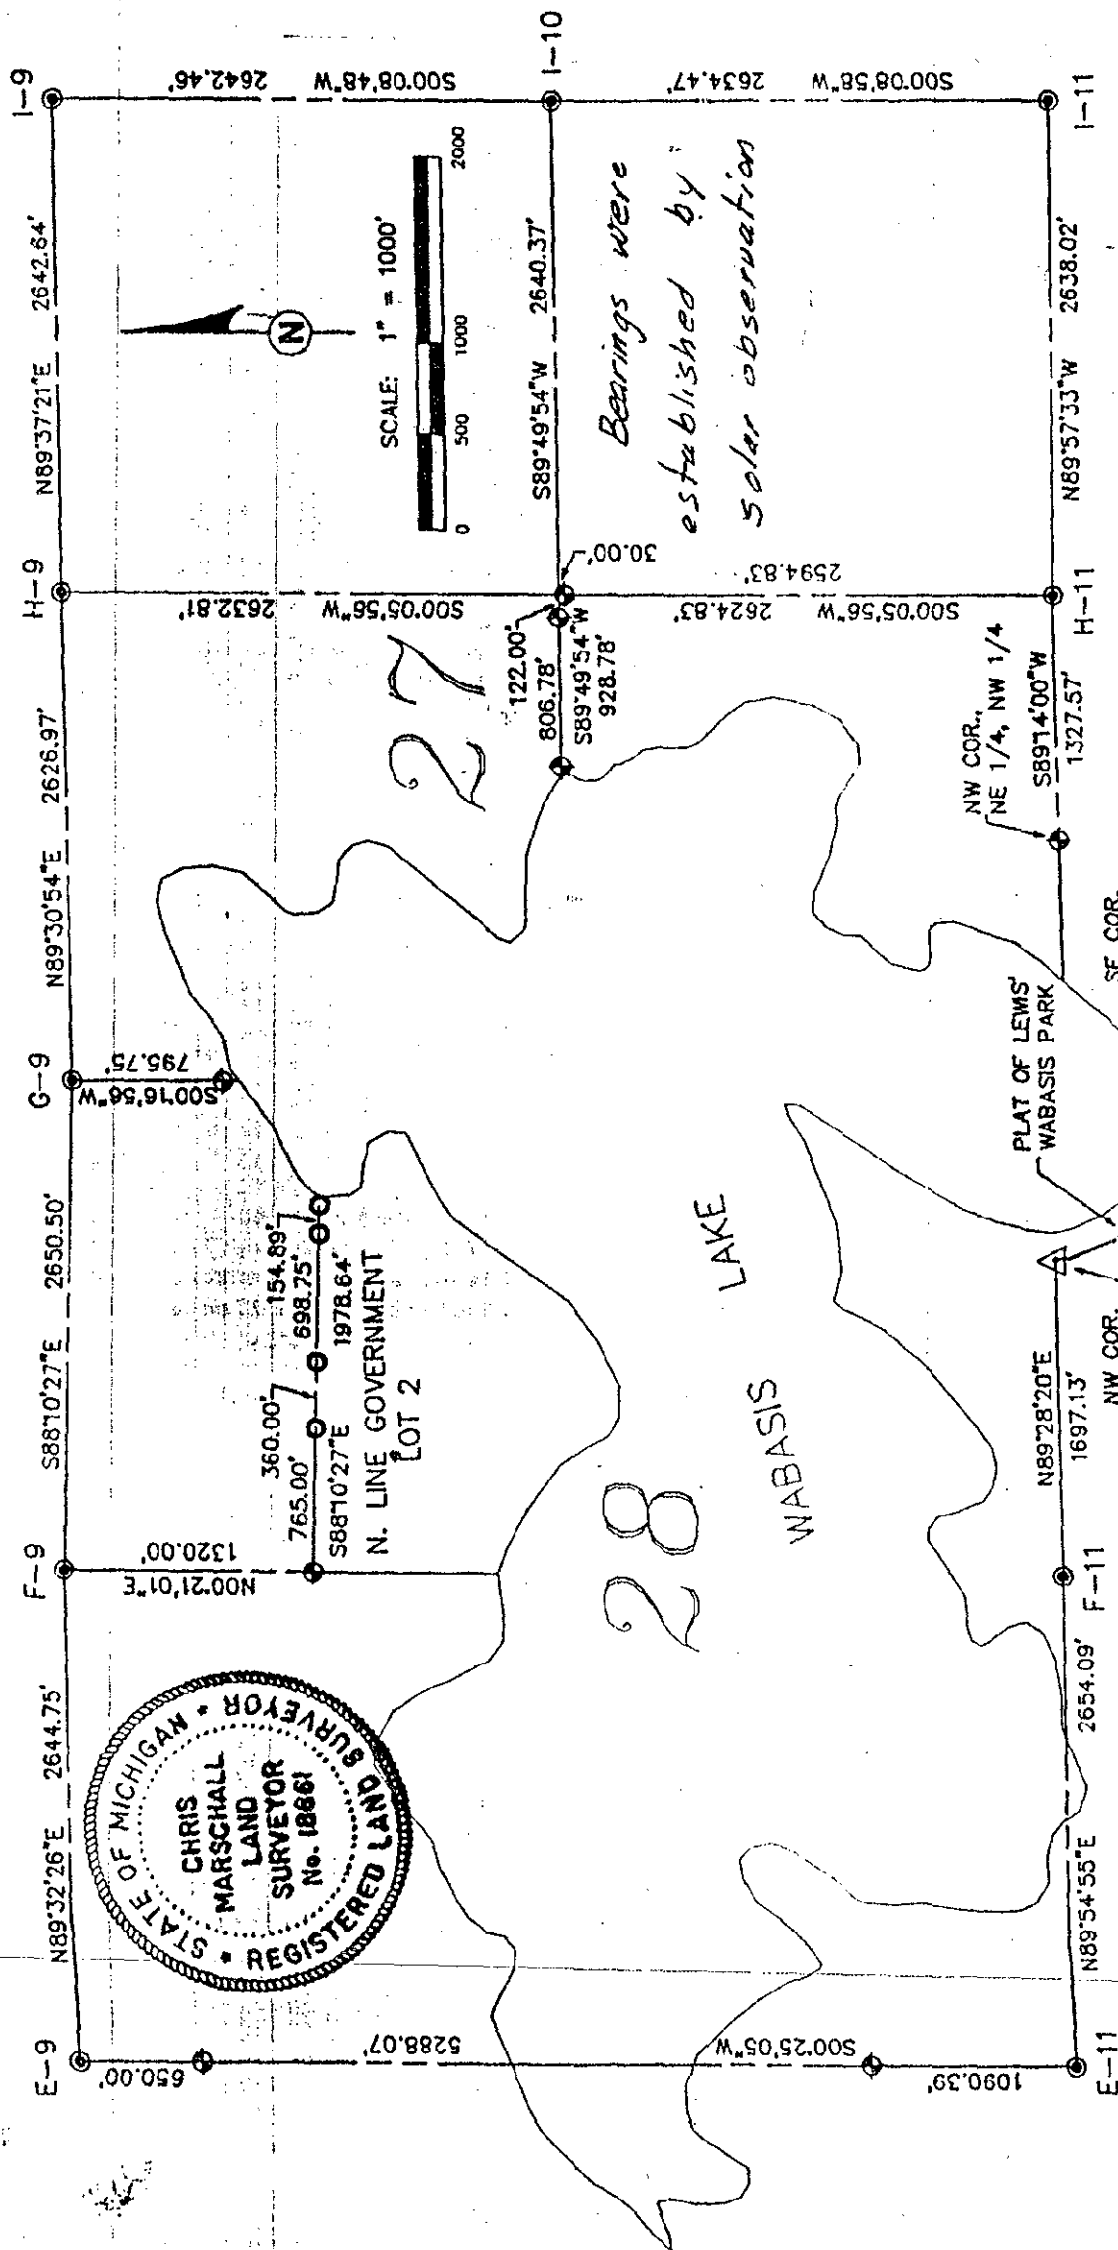

LMN
ENGINEERING
CONSULTANTS
INC.

4095 CHICAGO DRIVE
 GRANDVILLE, MI 48818
 (616) 334-0110

I, Chris Marschall, a Professional Surveyor in the State of Michigan, HEREBY CERTIFY that I have surveyed the parcel(s) of land described and delineated hereon; that said plat is a true representation of the survey as performed by me, and that there are no encroachments other than as shown hereon; that said survey was performed with the requirements of Act # 32, P.A. 1970, and that, having fully complied with the requirements of Act # 32, P.A. 1970,

1/19-93