

3/2

KENT COUNTY REMONUMENTATION
LAND CORNER RECORDATION CERTIFICATE
Filing Requirement of Act 74, Mich. P.A. 1970

For corners in

Kent
(County)

Located In:

Oakfield Township

Corner Code #

1 Public Land Survey

T R

T R

T R

T R

2 Property Controlling
in Section

S T R

S T R

3 Miscellaneous
Property in Sec.

S 33 T 9N R 9W

S T R

E. line Sec. 33

STATE OF MICHIGAN
RECORDS
93 MAY 1993
REGISTERED

6823 A

Register of Deeds Stamp & File Number

4 Lot No.

Recorded Plat

5 Private Claims

I, Chris Marschall, in a field survey on May, 19 93
do hereby certify that under requirements of P.A. 74, Michigan P.A. of 1970, the corner points mentioned
in lines 1 and 2 above were in conformance with regulations and rules therefore as required in the
current manual of survey instructions of the United States Department of the Interior, Bureau of Land
Management or by a decree of a Court of Law and/or that the corner points mentioned in lines 3, 4 and 5
above were in conformance with the rules of the Michigan Board of Land Surveyors or by a Decree of a
Court of Law; established, re-established, monumented, re-monumented, recovered, found as
expressed below:

NOTE: Not more than 4 corners, all in the same town and range, may be recorded
on this certificate.

A. Description of original monument and accessories and/or subsequent restoration:

GLO Set Post 71.50 Chains N. of SE corner of SEction 33 with witnesses

W. Oak 24" N61°E 47L

R. Oak 18" N 8°W 32L

Lewis' Wabasis Park (Plat recorded L45 p 34) 1949

B. Description of corner evidence found and/or method applied in restoring or reestablishing corner:

Found Concrete Plat monument (POB) SE corner Lot 30
Lewis' Wabasis Park. Held as the East line of Section 33.

C. Description of monument for corner and accessories established to perpetuate locating the position of the corner:

4" Concrete Plat Monument

Nail and Tag in E. side U.P.

South 60.30'

Nail and Tag in SE side 22" Oak

S 45°W 47.34'

Nail and Tag in N. side 8" Maple clump (6 trees)

S 70°E 29.33'

Nail and Tag in N. side 20" Oak


N 50°W 31.44'

Top of Bank

N 45°W 25'±

Monument extend 18" above grade at the top of the Hill.

	A	B	C	D	E	F	G	H	I	J	K	L	M
2	6		5		4		3		2				
3													
4	7		8		9		10		11		12		
5													
6	18		17		16		15		14		13		
7													
8	19		20		21		22		23		24		
9													
10	30		29		28		27		26		25		
11													
12	31		32		33		34		35		36		
13													

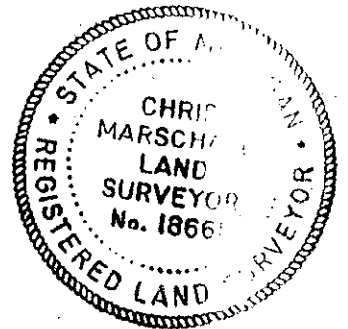

Signed by Chris Marschall

Date May 1993

Surveyor's Michigan License No. 18661

FORM APPROVED BY MICHIGAN STATE BOARD OF LAND SURVEYORS, JAN. 28, 1971
REVISED MAY 14, 1975
REVISED JAN., 1983

SEE OTHER SIDE

6823B

SECTION 27 AND 28, T9N, R9W,
 OAKFIELD TOWNSHIP, KENT COUNTY
 MICHIGAN

