

KENT COUNTY REMONUMENTATION
LAND CORNER RECORDATION CERTIFICATE
Filing Requirement of Act 74, Mich. P.A. 1970
Oakfield Township

For corners in

Kent
(County)

Located In:

Corner Code #

1. Public Land Survey

T _____ R _____
T _____ R _____
T _____ R _____
T _____ R _____

Other Code
#9

2. Property Controlling
in Section

S _____ T _____ R _____
S _____ T _____ R _____

3. Miscellaneous
Property in Sec.

S 29 T 9N R 9W
S _____ T _____ R _____

Witness Corner
E. line Sec. 29
(N. end of S. portion)

4. Lot No. _____, Recorded Plat _____

5. Private Claims _____

I, Chris Marschall, in a field survey on May, 1993

do hereby certify that under requirements of P.A. 74, Michigan P.A. of 1970, the corner points mentioned in lines 1 and 2 above were in conformance with regulations and rules therefore as required in the current manual of survey instructions of the United States Department of the Interior, Bureau of Land Management or by a decree of a Court of Law and/or that the corner points mentioned in lines 3, 4 and 5 above were in conformance with the rules of the Michigan Board of Land Surveyors or by a Decree of a Court of Law; established, re-established, monumented, re-monumented, recovered, found as expressed below:

NOTE: Not more than 4 corners, all in the same town and range, may be recorded on this certificate.

A. Description of original monument and accessories and/or subsequent restoration:

GLO Set posts at 28.50 Chains on the South side of the lake with witnesses Cedar 18" N 60°W 14L and Cedar 30" S 6°E 14L and at 45.50 Chains on the N. side of lake with witnesses Lynn 6" S 30°W 6L
Lynn 6" N 35°E 11L

GLO also notes a 20" Hickory line tree at 23.12 Chains North of the SE corner of Section 29.

B. Description of corner evidence found and/or method applied in restoring or reestablishing corner:

Found no evidence of GLO posts. However did locate a 3/4" pipe approximately 1300' South of the NE corner of Section 29, in an old E-W fence line. Said 3/4" pipe is on the straight line from the NE corner to the SE corner and this is the bearing that was held for the E. line of Section 29.

C. Description of monument for corner and accessories established to perpetuate locating the position of the corner:

Set 30" Harrison with witness corner cap in the park on the high plateau
Nail and Tag in E. side of 16" Oak S 02°W 26.18'
Nail and Tag in S. side of 18" Oak S 53°W 33.27'
Nail and Tag in W. side of 12" Oak N 52°W 17.21'
Nail and Tag in W. side of 20" Maple N 12°W 60.54'
SE corner Caretaker Building North 273'±
SW corner Bit. Parking lot N 16°E 149'±
Top of Bank South 40'±
Top of Bank West 130'±
SE corner Section 29 South 1090.39'

Signed by Chris Marschall
Surveyor's Michigan License No. 18661

Date May 1993

FORM APPROVED BY MICHIGAN STATE BOARD OF LAND SURVEYORS, JAN. 28, '91
REVISED MAY 14, '91
REVISED JAN., '91

SEE OTHER SIDE

STATE OF MICHIGAN
COUNTY OF KENT
RECEIVED
93 AUG 26 1993
REG. OF DEEDS


6828A

Register of Deeds Stamp & File Number

	A	B	C	D	E	F	G	H	I	J	K	L	M
2	6		5		4		3		2		1		
3													
4	7		8		9		10		11		12		
5													
6	18		17		16		15		14		13		
7													
8	19		20		21		22		23		24		
9													
10	30		29		28		27		26		25		
11													
12	31		32		33		34		35		36		
13													




6828B

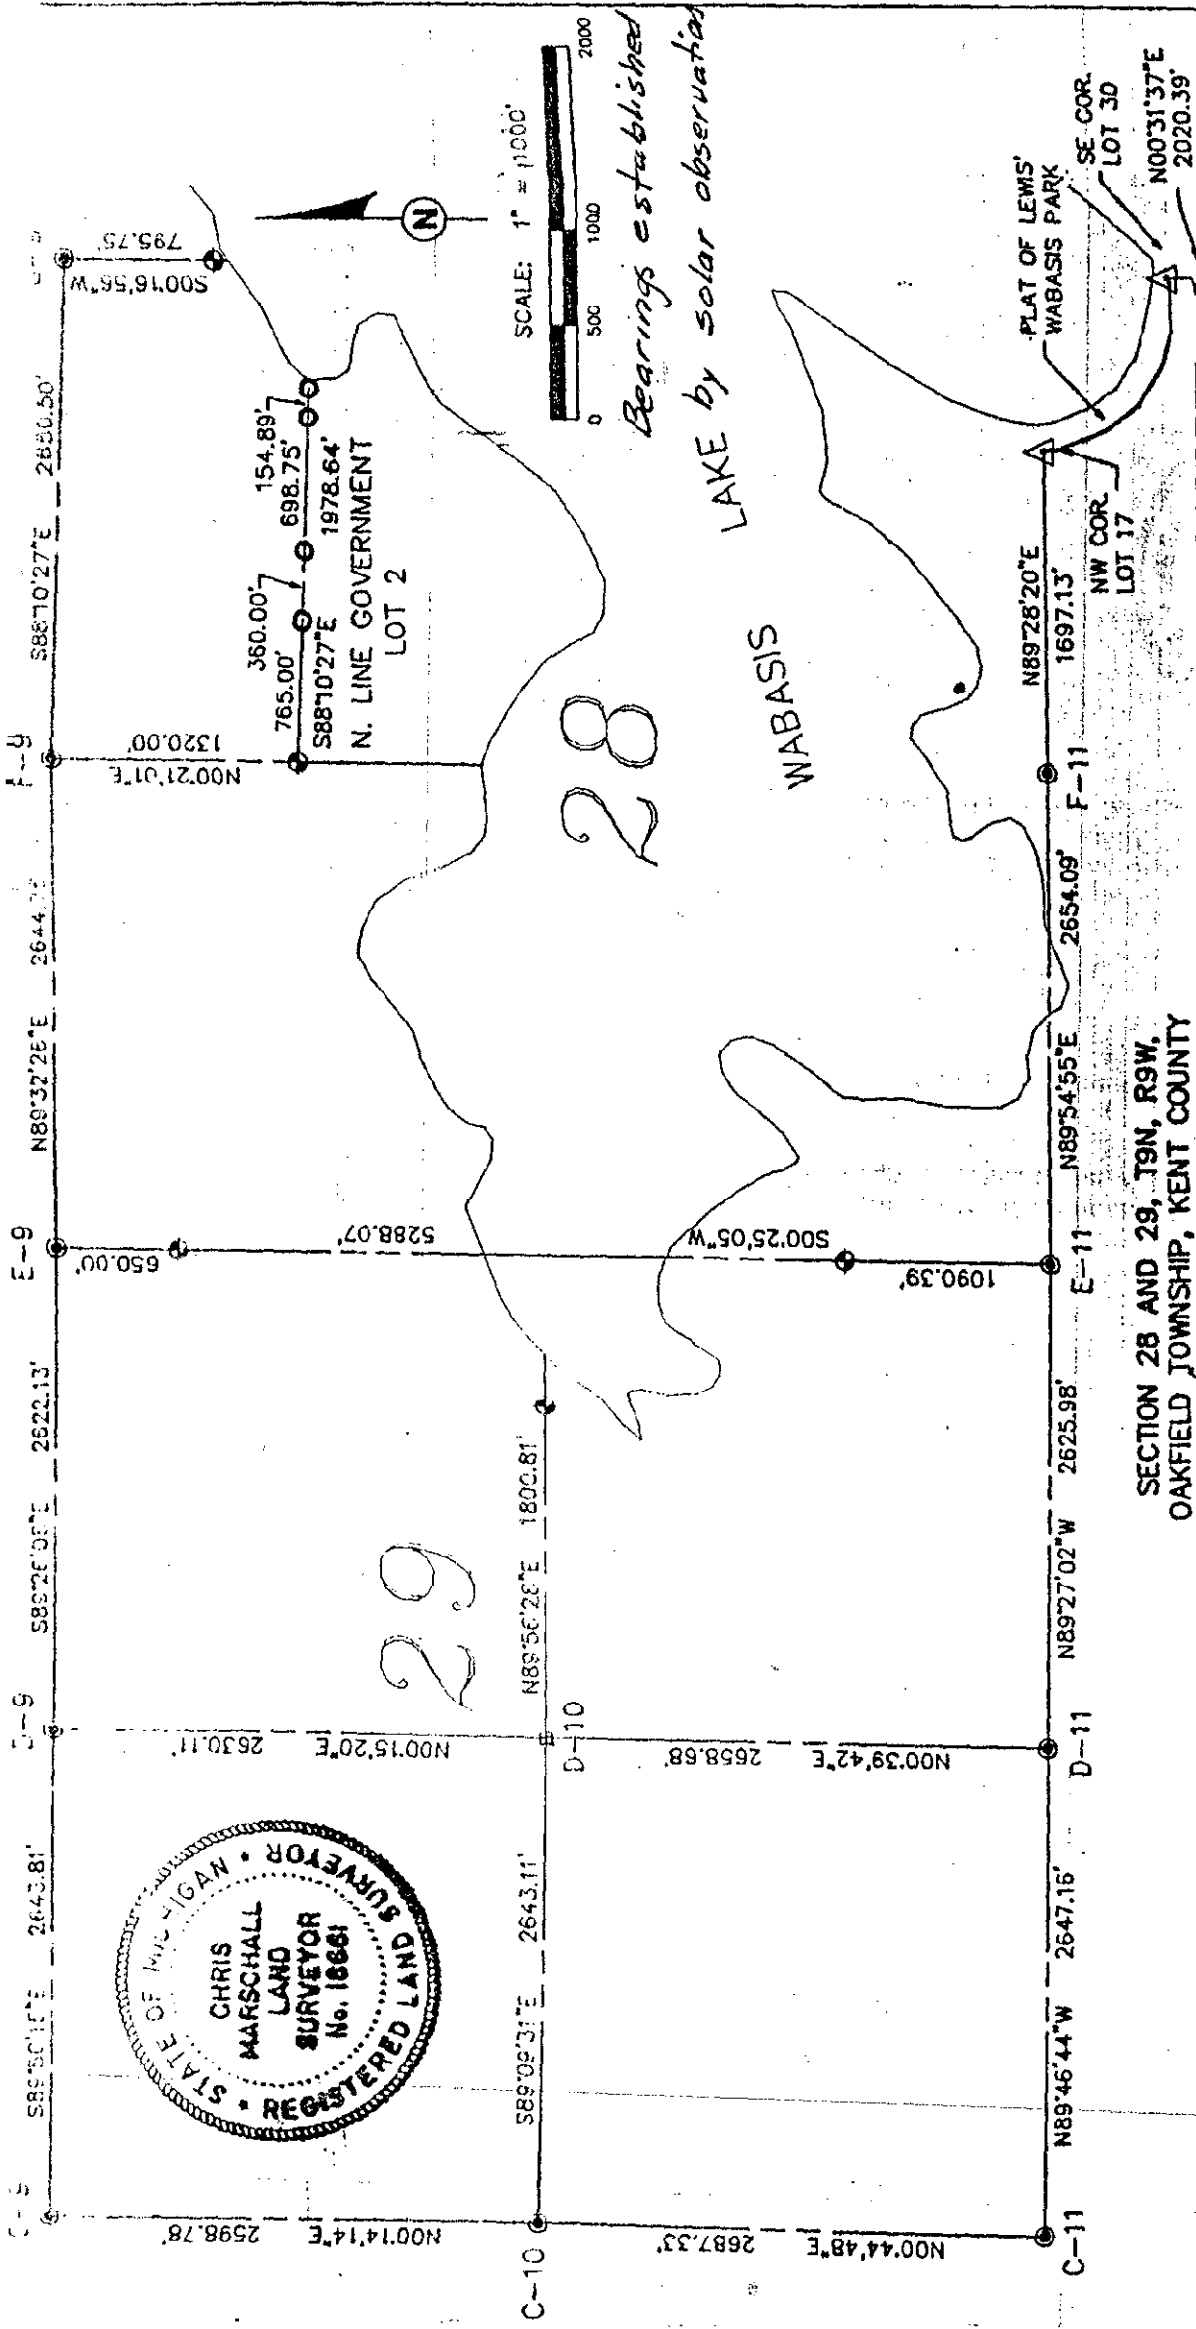

LMN ENGINEERING CONSULTANTS INC.
4095 CHICAGO DRIVE
GRANDVILLE, MI. 49418
(616)-534-0110

- LEGEND
- Witness Monument (Harrison Monument) - SET
 - Government Corner (Harrison Monument) - EXISTING
 - Center of Section (Harrison Monument) - SET
 - Concrete Monument (Plat Corner) - EXISTING
 - Point along Line (1/2" Iron) - SET

SECTION 28 AND 29, T9N, R9W,
OAKFIELD TOWNSHIP, KENT COUNTY
MICHIGAN

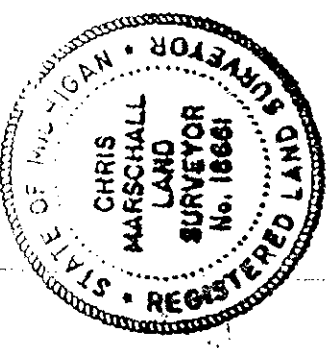

I, Chris Marschall, a Professional Surveyor in the State of Michigan, HEREBY CERTIFY that I have surveyed the parcel(s) of land described and delineated hereon; that said plot is a true representation of the survey as performed by me, and that there are no encroachments other than as shown hereon; that said survey was performed with an error of closure 1:50,000 and that I have fully complied with the requirements of Act # 132, P.A. 1970.

By Chris Marschall date 6-19-93
CHRIS MARSCHALL, P.S. No. 18661