

Kent County Remonumentation
LAND CORNER RECORDATION CERTIFICATE
Filing Requirement of Act 74, Mich. P.A. 1970

STATE OF MICHIGAN
COUNTY OF KENT
RECEIVED FOR RECORD
93 JUL 23 AM 10:30

For corners in

Kent
(County)

Located In:

Corner Code --#

1. Public Land Survey T R
T R
T R
T R
2. Property Controlling S T R
in Section S 22 T 10N R 9W Spencer Twp.
3. Miscellaneous S T R
Property in Sec. S T R

4. Lot No. , Recorded Plat
5. Private Claims

I, John C. Bueche, in a field survey on June, 19 93,
do hereby certify that under requirements of P.A. 74, Michigan P.A. of 1970, the corner points mentioned
in lines 1 and 2 above were in conformance with regulations and rules therefore as required in the
current manual of survey instructions of the United States Department of the Interior, Bureau of Land
Management or by a decree of a Court of Law and/or that the corner points mentioned in lines 3, 4 and 5
above were in conformance with the rules of the Michigan Board of Land Surveyors or by a Decree of a
Court of Law; established, re-established, monumented, re-monumented, recovered, found as
expressed below:

**NOTE: Not more than 4 corners, all in the same town and range, may be recorded
on this certificate.**

A. Description of original monument and accessories and/or subsequent restoration:


This point never set by G.L.O.

B. Description of corner evidence found and/or method applied in restoring or reestablishing corner:

Set on mean bearing to the Lake between the N Line & S Line of
Sec. 22; set cor. at 1540.19' E of W 1/4 cor. of Sec. 22 on
E-W 1/4 Line (on W side Lake only)

C. Description of monument for corner and accessories established to perpetuate locating the position of the corner:

Set Std. K.C. Mon. (Harrison 4" x 30")
NW cor. conc. garage fnd. #12249 Verlin Rd. N 55° E 42.03'
SW cor. conc. garage fnd. #12249 Verlin Rd. N 85° E 51.67'
K.C. Remon. Tag & Nail in N side pole N 25° E 41.11'
NW cor. conc. dr. S 70° E 90.80'
W edge bit. East 1'±
Meas. by hand

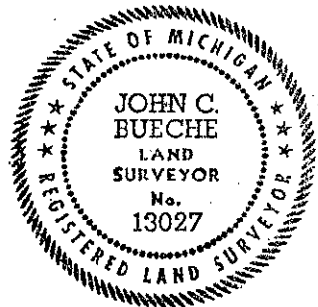

Signed by John C Bueche Date June 10, 1993
Surveyor's Michigan License No. 13027