

# SURVEY & REMONUMENTATION

1993

Other

# SURVEY & REMONUMENTATION

MAY 09 1996

COMMISSION

## Kent County Remonumentation COMMISSION LAND CORNER RECORDATION CERTIFICATE Filing Requirement of Act 74, Mich. P.A. 1970

For corners in

Kent

(County)

Located In:

Corner Code #

1. Public Land Survey

T R

Other Code

T R

#8

T R

T R

2. Property Controlling  
in Section

S 22 T 10N R 9W

Spencer Twp.

S 27 T 10N R 9W

3. Miscellaneous  
Property in Sec.

S T R

S T R

4. Lot No. , Recorded Plat

5. Private Claims

Register of Deeds Stamp & File Number

6796

I, John C. Bueche, in a field survey on June, 19 93,  
do hereby certify that under requirements of P.A. 74, Michigan P.A. of 1970, the corner points mentioned  
in lines 1 and 2 above were in conformance with regulations and rules therefore as required in the  
current manual of survey instructions of the United States Department of the Interior, Bureau of Land  
Management or by a decree of a Court of Law and/or that the corner points mentioned in lines 3, 4 and 5  
above were in conformance with the rules of the Michigan Board of Land Surveyors or by a Decree of a  
Court of Law; established, re-established, monumented, re-monumented, recovered, found as  
expressed below:

NOTE: Not more than 4 corners, all in the same town and range, may be recorded  
on this certificate.

A. Description of original monument and accessories and/or subsequent restoration:


This point never set by G.L.O.

B. Description of corner evidence found and/or method applied in restoring or reestablishing corner:

Set witness monument 916.76' W. of the N 1/4 Cor Sec 27 on the N line of Sec 27.

-C. Description of monument for corner and accessories established to perpetuate locating the position of the corner:

Set Std. K.C. Mon. (Harrison 4" x 30") 916.76' W of the N 1/4  
cor. Sec. 27 on the N Line of Sec. 27  
NW cor. conc. S 40° E 20.90'  
K.C. Remon. Tag & Nail in W side 14" Box Elder N 0° E 30.12'  
K.C. Remon. Tag & Nail in S side 8" Maple N 55° W 36.86'  
K.C. Remon. Tag & Nail in NW side dbl. 10" Box Elder S 65° W 38.88'  
E edge bit. Hemlock W 5'±  
C/L 18 Mile Rd. S 100'±  
Meas. by hand

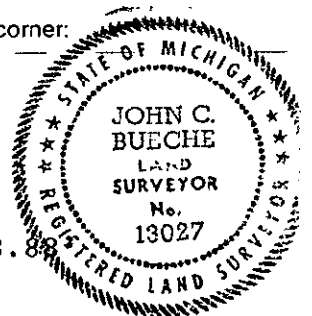

Signed by John C. Bueche

Date June 10, 1993

Surveyor's Michigan License No. 13027