

# SURVEY & REMONUMENTATION

MAY 09 1996

other  
LAND CORNER RECORDATION CERTIFICATE  
Filing Requirement of Act 74, Mich. P.A. 1970

STATE OF MICHIGAN  
COUNTY OF KENT  
RECEIVED FOR FILING

93 SEP -7 PM 1:55

For corners in

COMMISSION

Kent

(County)

Located In:

Corner Code: 11

1. Public Land Survey

T 10N R 9W

South witness

monument to K-12

2. Property Controlling  
in Section

S T R

Other Code

3. Miscellaneous  
Property in Sec.

S T R

#11

4. Lot No.

Recorded Plat

5. Private Claims

6834  
Register of Deeds Stamp & File Number

I, Wallace E. Glaza, in a field survey on July 9, 19 93

do hereby certify that under requirements of P.A. 74, Michigan P.A. of 1970, the corner points mentioned in lines 1 and 2 above were in conformance with regulations and rules therefore as required in the current manual of survey instructions of the United States Department of the Interior, Bureau of Land Management or by a decree of a Court of Law and/or that the corner points mentioned in lines 3, 4 and 5 above were in conformance with the rules of the Michigan Board of Land Surveyors or by a Decree of a Court of Law; established, re-established, monumented, re-monumented, recovered, found as expressed below:

NOTE: Not more than 4 corners, all in the same town and range, may be recorded on this certificate.

A. Description of original monument and accessories and/or subsequent restoration

No previous history.

B. Description of corner evidence found and/or method applied in restoring or reestablishing corner:


South witness monument to K-12, T10N, R9W, Spencer Township, Kent County, Michigan.

Set standard 4" x 30" Harrison Monument 31' South and 26' East of waters edge of Half Mile Lake on a straight line between the Southwest corner of Section 36 and the  $\frac{1}{4}$  corner as established for the SE  $\frac{1}{4}$  of Section 35 and SW  $\frac{1}{4}$  of Section 36.

C. Description of monument for corner and accessories established to perpetuate locating the position of the corner:

South witness monument to K-12 (4" x 30" standard Harrison Monument)

- 1) Nail and tag in NW side 10" Pine N70°E 5.76'
- 2) Nail and tag in SW side 32" Oak S40°E 35.54'
- 3) Nail and tag in W side 14" Maple S35°W 5.09'
- 4) Southwest corner of screen porch S70°E 34.04'
- 5) SE corner of 3' x 3' conc blk BBQ N57°W 12.97'

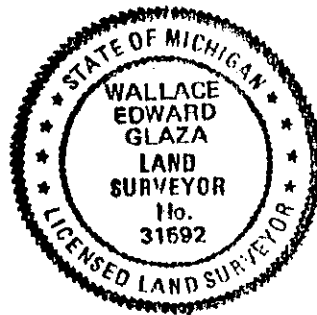

Signed by

*Wallace E. Glaza*

Date

8-12-93

Surveyor's Michigan License No.

31592