

SURVEY & REMONUMENTATION

MAY 09 1996

Other

LAND CORNER RECORDATION CERTIFICATE COMMISSION

Filing Requirement of Act 74, Mich. P.A. 1970

For corners in

Kent

(County)

Located In:

Corner Code #1

1. Public Land Survey

T 10N R 9W

East witness
monument to K-12

2. Property Controlling
in Section

S

T R

Other Code

3. Miscellaneous
Property in Sec.

S

T R

#12

4. Lot No. , Recorded Plat

5. Private Claims

STATE OF MICHIGAN
COUNTY OF KENT
RECEIVED
03 SEP -7 PM 1:51

Wallace E. Glaza
REG. OF DEEDS

6835

Register of Deeds Stamp & File Number

Wallace E. Glaza, in a field survey on July 9, 1993

do hereby certify that under requirements of P.A. 74, Michigan P.A. of 1970, the corner points mentioned in lines 1 and 2 above were in conformance with regulations and rules therefore as required in the current manual of survey instructions of the United States Department of the Interior, Bureau of Land Management or by a decree of a Court of Law and/or that the corner points mentioned in lines 3, 4 and 5 above were in conformance with the rules of the Michigan Board of Land Surveyors or by a Decree of a Court of Law; established, re-established, monumented, re-monumented, recovered, found as expressed below:

NOTE: Not more than 4 corners, all in the same town and range, may be recorded on this certificate.

A. Description of original monument and accessories and/or subsequent restoration:

No previous history.

B. Description of corner evidence found and/or method applied in restoring or reestablishing corner:

East witness monument to K-12, T10N, R9W, Spencer Township, Kent County, Michigan.


Set standard 4" x 30" Harrison Monument 26' East of Waters edge of Half Mile Lake on a straight line between the center of Section 36 and the West $\frac{1}{4}$ corner of Section 36 as established for the Northwest $\frac{1}{4}$ of Section 36.

Witness corner is 2534.14' West of the center of Section 36.

C. Description of monument for corner and accessories established to perpetuate locating the position of the corner:

East witness monument to K-12 (4" x 30" standard Harrison Monument)

- | | | |
|--|-------|--------|
| 1) Nail and tag in W side 32" Twin Maple | N20°E | 23.76' |
| 2) Nail and tag in E side 10" Pine | S10°W | 13.06' |
| 3) Nail and tag in N side 18" Oak | S65°E | 16.78' |
| 4) Nail and tag in S side 10" Pine | N85°W | 6.55' |
| 5) Northwest corner of house #13595 | S70°E | 48.07' |

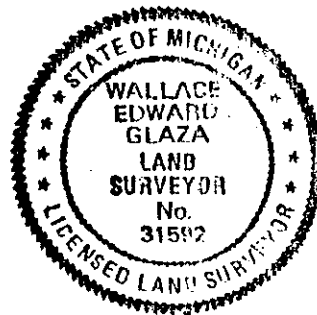

Signed by *Wallace E. Glaza*
Glaza and Associates, Inc. 31592

Date 8-12-93

Surveyor's Michigan License No.