

SURVEY & REMONUMENTATION

MAY 09 1996

other

COMMISSION

LAND CORNER RECORDATION CERTIFICATE
Filing Requirement of Act 74, Mich. P.A. 1970

For corners in

Kent

(County)

Located In:

OLON TOWNSHIP

Corner Code //

1. Public Land Survey T 10N R 11W
2. Property Controlling S T R
3. Miscellaneous S T R
- Property in Sec S T R

West witness
monument to F-1

other code
#1

6802

Register of Deeds Stamp & File Number

4. Lot No. , Recorded Plat
5. Private Claims

Wallace E. Glaza, in a field survey on July 22, 1993

do hereby certify that under requirements of P.A. 74, Michigan P.A. of 1970, the corner points mentioned in lines 1 and 2 above were in conformance with regulations and rules therefore as required in the current manual of survey instructions of the United States Department of the Interior, Bureau of Land Management or by a decree of a Court of Law and/or that the corner points mentioned in lines 3, 4 and 5 above were in conformance with the rules of the Michigan Board of Land Surveyors or by a Decree of a Court of Law; established, re-established, monumented, re-monumented, recovered, found as expressed below:

NOTE: Not more than 4 corners, all in the same town and range, may be recorded on this certificate.

A Description of original monument and accessories and/or subsequent restoration:

No previous history.

| | A | B | C | D | E | F | G | H | I | J | K | L | M |
|----|----|---|----|---|----|---|---|----|---|---|----|---|----|
| 2 | 6 | | 5 | | 4 | | | 3 | | | 2 | | 1 |
| 3 | | | | | | | | | | | | | |
| 4 | 7 | | 8 | | 9 | | | 10 | | | 11 | | 12 |
| 5 | | | | | | | | | | | | | |
| 6 | 18 | | 17 | | 16 | | | 15 | | | 14 | | 13 |
| 7 | | | | | | | | | | | | | |
| 8 | 19 | | 20 | | 21 | | | 22 | | | 23 | | 24 |
| 9 | | | | | | | | | | | | | |
| 10 | 30 | | 29 | | 28 | | | 27 | | | 26 | | 25 |
| 11 | | | | | | | | | | | | | |
| 12 | 31 | | 32 | | 33 | | | 34 | | | 35 | | 36 |
| 13 | | | | | | | | | | | | | |

B. Description of corner evidence found and/or method applied in restoring or reestablishing corner:

West witness monument to F-1, Section 4, T10N, R11W, Solon Township, Kent County, Michigan.


Set standard 4" x 30" Harrison Monument 72'± West of waters edge of Gilbert Lake on a straight line between the NW corner of Section 4, T10N, R11W, Solon Township, and South 1/4 corner of Section 34, T11N, R11W, Ensley Township, Newaygo County, Michigan.

Witness corner is 1823.04' East of Northwest corner.

C. Description of monument for corner and accessories established to perpetuate locating the position of the corner

West witness monument to F-1 (4" x 30" standard Harrison Monument)

- 1) Nail and tag in E side 30" Oak N18°W 21.71'
- 2) Nail and tag in S side 42" Oak N73°E 41.17'
- 3) Nail and tag in E side 12" maple S19°E 38.92'
- 4) Nail and tag in N side 10" maple S66°W 26.85'
- 5) SE corner house #7086 N55°W 63.00'

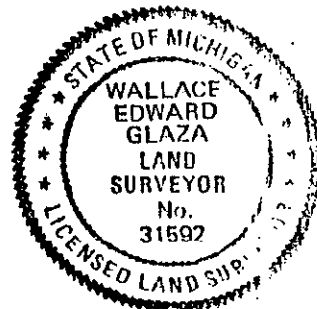

Signed by

Glaza and Associates, Inc.

Surveyor's Michigan License No.

31592

Date

8-9-93