

SURVEY & REMONUMENTATION

MAY 09 1996

Other

LAND CORNER RECORDATION CERTIFICATE COMMISSION Filing Requirement of Act 74, Mich. P.A. 1970

93 AUG 12 1996

For corners in

Kent
(County)

Located in:

Corner Code //

1. Public Land Survey

T 10N R 11W

East witness
monument to J-3

T R

T R

T R

2. Property Controlling
in Section

S T R

S T R

3. Miscellaneous

S T R

Property in Sec.

S T R

Other Code

#7

6809

Register of Deeds Stamp & File Number

4. Lot No. Recorded Plat

5. Private Claims

	A	B	C	D	E	F	G	H	I	J	K	L	M
2	6		5		4		3		2		1		
3													
4	7		8		9		10		11		12		
5													
6	13		14		15		16		17		18		
7													
8	19		20		21		22		23		24		
9													
10	25		26		27		28		29		30		
11													
12	31		32		33		34		35		36		
13													

Wallace E. Glaza, in a field survey on August 12, 1993, do hereby certify that under requirements of P.A. 74, Michigan P.A. of 1970, the corner points mentioned in lines 1 and 2 above were in conformance with regulations and rules therefore as required in the current manual of survey instructions of the United States Department of the Interior, Bureau of Land Management or by a decree of a Court of Law and/or that the corner points mentioned in lines 3, 4 and 5 above were in conformance with the rules of the Michigan Board of Land Surveyors or by a Decree of a Court of Law; established, re-established, monumented, re-monumented, recovered, found as expressed below:

NOTE: Not more than 4 corners, all in the same town and range, may be recorded on this certificate.

A. Description of original monument and accessories and/or subsequent restoration

No previous history.

B. Description of corner evidence found and/or method applied in restoring or reestablishing corner:


East witness monument to J-3, T10N, R11W, Solon Township, Kent County, Michigan.

Set standard 4" x 30" Harrison Monument on a straight line between K-3 and the computed location of J-3, 2026.10' West of K-3.

C. Description of monument for corner and accessories established to perpetuate locating the position of the corner:

East witness monument to J-3 (standard 4" x 30" Harrison Monument)

- 1) Nail and tag in NW side 8" Oak S65°W 13.99'
- 2) Nail and tag in SW side 14" Oak N38°W 10.79'
- 3) Nail and tag in SE side 24" Maple N38°E 49.52'
- 4) Nail and tag in N side 24" Maple N79°E 51.03'
- 5) Nail and tag in W side 36" Oak S25°E 52.62'
- 6) Centerline of two-track South 160'±

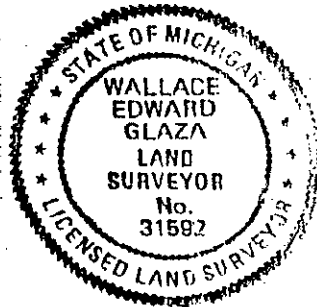

Signed by *Wallace E. Glaza*
Glaza and Associates, Inc.

31592

Date

8-17-93