

SURVEY & REMONUMENTATION

JAN 21 1998

LAND CORNER RECORDATION CERTIFICATE
Filing Requirement of Act 74, Mich. P.A. 1970

For corners **SECTION**
Keweenaw

(County)

Located In:

Corner Code ##

1. Public Land Survey

T 57N R 29W
T 57N R 29W

MC 15

H-1

2. Property Controlling
in Section

S T R
S T R

3. Miscellaneous
Property in Sec.

S T R
S T R

REGISTER'S OFFICE

County of Keweenaw } SS

Received for Record, the 20th
day of December A.D. 19 97
at 10:00 o'clock A.M. and Recorded
in Liber 1 of LCR
on page 173

Julie Gaillet, Deputy
Register of Deeds

Register of Deeds Stamp & File Number

4. Lot No. _____, Recorded Plat _____
5. Private Claims _____

I, John Haataja, in a field survey on 11/7, 19 97, do hereby certify that under requirements of P.A. 74, Michigan P.A. of 1970, the corner points mentioned in lines 1 and 2 above were in conformance with regulations and rules therefore as required in the current manual of survey instructions of the United States Department of the Interior, Bureau of Land Management or by a decree of a Court of Law and/or that the corner points mentioned in lines 3, 4 and 5 above were in conformance with the rules of the Michigan Board of Land Surveyors or by a Decree of a Court of Law; established, re-established, monumented, re-monumented, recovered, found as expressed below:

NOTE: Not more than 4 corners, all in the same town and range, may be recorded on this certificate.

A. Description of original monument and accessories and/or subsequent restoration:

MC 15 Wood post set in 1847
Spruce 6" N49°E 10 LKS

H-1 Wood post set in 1847.
W. Pine 12" N60°E 17 LKS
W. Pine 9" S30°W 98 LKS

B. Description of corner evidence found and/or method applied in restoring or reestablishing corner:


MC 15 No evidence of original corner found.
Set MC on South section line of Section
34 at high watermark.

H-1 S½ corner was reestablished in
1990. And recorded in LCR 1, Page 87,
Keweenaw County Records. Corner was
reestablished as called for in
description of U.S. Lighthouse Parcel.

C. Description of monument for corner and accessories established to perpetuate locating the position of the corner:

MC 15 Set 1" pipe with brass cap
16" W. Pine N20°W 63.95'
18" W. Pine N24°E 44.07'
16" W. Pine S86°E 40.80'
18" W. Pine S01°W 22.00'

H-1 Set 1" pipe with brass cap
15" R. Pine N02°E 17.00'
9" W. Pine S67°E 6.99'
15" W. Pine S15°E 23.04'
24" W. Pine N82°W 11.45'

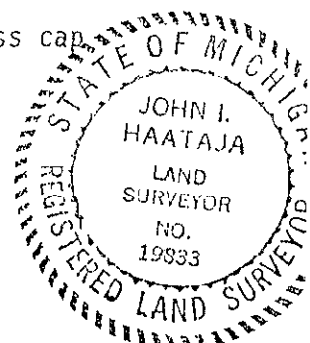

Signed by John I. Haataja

Date 12/30/1997

Surveyor's Michigan License No. 19833