

SURVEY &  
REMONUMENTATION

APR 28 1995

COMMISSION

LAND CORNER RECORDATION CERTIFICATE

Filing Requirement of Act 74, Mich. P.A. 1970

For corners in

Keweenaw

(County)

Located In:

Corner Code #

1. Public Land Survey

T 57N R 32W

C-3

T 57N R 32W

C-2

2. Property Controlling  
in Section

S T R

3. Miscellaneous

S T R

Property in Sec.

S T R

4. Lot No. , Recorded Plat

5. Private Claims

REGISTER'S OFFICE

County of Keweenaw } SS

Received for Record, the

day of December A.D. 1994

at 3:00 o'clock P.M., and Recorded

in Liber 1 of L.C.R.

on page 126

Register of Deeds

Register of Deeds Stamp & File Number

I, John I. Haataja, in a field survey on November 3, 1994

do hereby certify that under requirements of P.A. 74, Michigan P.A. of 1970, the corner points mentioned in lines 1 and 2 above were in conformance with regulations and rules therefore as required in the current manual of survey instructions of the United States Department of the Interior, Bureau of Land Management or by a decree of a Court of Law and/or that the corner points mentioned in lines 3, 4 and 5 above were in conformance with the rules of the Michigan Board of Land Surveyors or by a Decree of a Court of Law; established, re-established, monumented, re-monumented, recovered, found as expressed below:

NOTE: Not more than 4 corners, all in the same town and range, may be recorded on this certificate.

A. Description of original monument and accessories and/or subsequent restoration:


C-3 Sec. Corner 5,6,7 & 8, T57N-R32W  
Orig. Notes: Wood Post in 1846 by  
S. W. Hill  
Spruce 8" S 60° W 31 lks.  
Y. Birch 12" N 40° E 28 lks.

C-2 1/4 Corner between Sec. 5 & 6  
Orig. Notes: 16" Cedar for corner.  
Fir 12" N 10° W 15 lks.  
Spruce 12" S 80° E 15 lks.

B. Description of corner evidence found and/or method applied in restoring or reestablishing corner:

C-3 Sec. Corner 5,6,7 & 8, T57N-R32W  
No trace of original corner.  
Re-established corner by double  
proportionate measure between  
adjacent established corners.

C-2 1/4 Corner between Sec. 5 & 6  
No trace of original corner. Re-es-  
tablished corner by single proportionate  
measure between Section Corners.

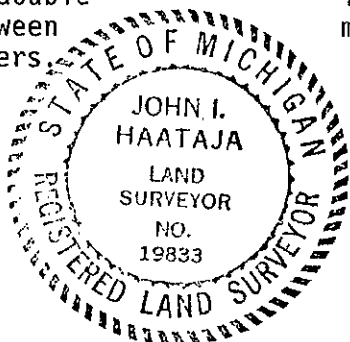

Ratified by Peer Group  
In accordance with P.A. 345

Co. Rep. James M. Habbick

Date 11/16/94

C. Description of monument for corner and accessories established to perpetuate locating the position of the corner:

C-3 Sec. Corner 5,6,7 & 8, T57N-R32W  
Set 1" iron pipe with brass cap as a  
careful and faithful re-establishment  
of the position of the original corner.  
8" Red Pine S 22° E 5.55'  
28" Aspen S 85° E 7.60'  
8" Red Maple N 27° E 13.50'  
4" Red Maple S 51° W 5.38'

C-2 1/4 Corner between Sec. 5 & 6  
Set 1" pipe with brass cap as a careful  
and faithful re-establishment of the  
position of the original corner.  
12" W. Spruce S 73° W 49.73'  
10" Balsam N 86° W 60.34'  
4" B. Ash N 23° W 89.59'  
8" W. Birch N 03° E 126.24'

Signed by John I. Haataja Date November 22, 1994  
Surveyor's Michigan License No. 19833