

SURVEY & REMONUMENTATION

MAR 19 1997

LAND CORNER RECORDATION CERTIFICATE Filing Requirement of Act 74, Mich. P.A. 1970

For corners in COMMISSION

Keweenaw
(County)

Located In:

Corner Code ##

1. Public Land Survey

T 58 R 29
T 58 R 29
T R
T R

E-3

E-5

2. Property Controlling
in Section

S T R
S T R

3. Miscellaneous
Property in Sec.

S T R
S T R

REGISTER'S OFFICE

County of Keweenaw } SS

Received for Record, the 9th
day of December A.D. 19 96
at 1:00 o'clock P.M., and Recorded
in Liber 1 of L.C.R.
on page 161
Roberta Roseberger Dyer
Register of Deed

Register of Deeds Stamp & File Number

4. Lot No. , Recorded Plat

5. Private Claims

I, John I. Haataja, in a field survey on September 15, 19 96,
do hereby certify that under requirements of P.A. 74, Michigan P.A. of 1970, the corner points mentioned
in lines 1 and 2 above were in conformance with regulations and rules therefore as required in the
current manual of survey instructions of the United States Department of the Interior, Bureau of Land
Management or by a decree of a Court of Law and/or that the corner points mentioned in lines 3, 4 and 5
above were in conformance with the rules of the Michigan Board of Land Surveyors or by a Decree of a
Court of Law; established, re-established, monumented, re-monumented, recovered, found as
expressed below:

NOTE: Not more than 4 corners, all in the same town and range, may be recorded
on this certificate.

A. Description of original monument and accessories and/or subsequent restoration:

E-3 SW cor. Sec. 4
Wood Post
Sugar 15" S 8 E 23 lks.
Fir 14" N 20 W 47 lks.

E-5 SW cor. Sec. 9
Wood Post
Sugar 18" S 10 W 51 lks.
Sugar 12" N 25 E 34 lks.

B. Description of corner evidence found and/or method applied in restoring or reestablishing corner:

E-3 FND. Cedar w/C&H tag & 4-wy B. Fir
Old C&H records call for post & B.T.
balsam stump. Re-established cor.
from tagged Cedar & 4-way B. Fir.

E-5 FND. 1-1/4" pipe and Maple B.T.
C&H surveyor (Kline) FND. same
in 1951.

Ratified by Peer Group


In accordance with P.A. 345

Co. Rep. James M. Hurlburt

Date 12/6/96

C. Description of monument for corner and accessories established to perpetuate locating the position of the corner:

E-3 SW cor. Sec. 4
1" pipe with brass cap
28" Cedar S 85° W 4.73'
15" Cedar S 1° E 7.19'
6" B. Fir S 84° E 6.49'
6" B. Fir N 9° W 6.12'

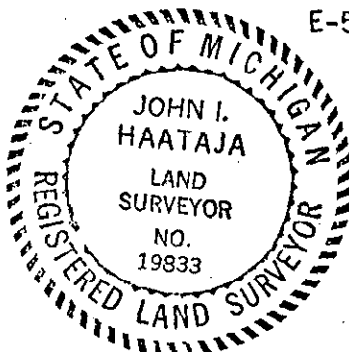

E-5 SW cor. Sec. 9
1-1/4" pipe with brass cap
16" Maple N 89 E 11.69'
14" Oak S 54 E 25.73'
8" Oak S 77 W 19.08'
4" Maple N 17 W 5.96'

igned by John I. Haataja
urveyor's Michigan License No. 19833

Date 11/27/96