

SURVEY &
REMONUMENTATION

APR 28 1995

COMMISSION

LAND CORNER RECORDATION CERTIFICATE
Filing Requirement of Act 74, Mich. P.A. 1970

For corners in

Keweenaw

(County)

Located In:

Corner Code ##

1. Public Land Survey

T 58N R 32W

E-12

T 58N R 32W

E-11/12

#3

2. Property Controlling
in Section

S T R

S T R

3. Miscellaneous
Property in Sec.

S T R

S T R

4. Lot No. , Recorded Plat

5. Private Claims

REGISTER'S OFFICE

County of Keweenaw } SS

Received for Record, the 15th

day of December A.D. 1994

at 3:00 o'clock P.M., and Recorded

in Liber 1 of LCR

on page 124

Register of Deeds

Register of Deeds Stamp & File Number

I, John I. Haataja, in a field survey on November 15, 1994

do hereby certify that under requirements of P.A. 74, Michigan P.A. of 1970, the corner points mentioned in lines 1 and 2 above were in conformance with regulations and rules therefore as required in the current manual of survey instructions of the United States Department of the Interior, Bureau of Land Management or by a decree of a Court of Law and/or that the corner points mentioned in lines 3, 4 and 5 above were in conformance with the rules of the Michigan Board of Land Surveyors or by a Decree of a Court of Law; established, re-established, monumented, re-monumented, recovered, found as expressed below:

NOTE: Not more than 4 corners, all in the same town and range, may be recorded on this certificate.

A. Description of original monument and accessories and/or subsequent restoration:

E-12 1/4 Corner between Sec. 32 & 33.

Orig. Notes: Wood Post

Aspen 8" N 30° E 10 lks.

Aspen 10" S 50° W 10 lks.

Original post found by Kline & Gillies in 1942. Iron pipe in concrete set in place of post.

E-11/12

MC between Sec. 32 & 33. Orig. Notes:

5" Y. Pine at H.W.M.

Y. Pine 27" S 65° W 14 lks.

Y. Pine 25" N 75° E 25 lks.

Iron pipe set in concrete on course and distance from B.T.s by Kline and Gillies on 6/12/44.

B. Description of corner evidence found and/or method applied in restoring or reestablishing corner:

E-12 1/4 Cor. between Sec. 32 & 33.

Found 3/4" pipe in concrete.

Referenced and recorded by Crampton.

Restored corner location at 3/4" iron pipe.


E-11/12

MC between Sec. 32 & 33.

Found 1 1/4" iron pipe in concrete at

HWM also original B.T.s visible.

Restored corner location at 1 1/4" iron pipe.

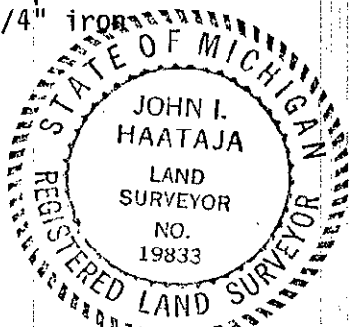

Ratified by Peer Group
In accordance with P.A. 345
Co. Rep. Thomas M. Hall
Date 11/16/94

C. Description of monument for corner and accessories established to perpetuate locating the position of the corner:

E-12 1/4 Corner between Sec. 32 & 33.

Set 1" pipe with brass cap in place of 3/4" pipe.

12" Aspen N 64° W 12.26'

8" Aspen S 80° E 4.50'

5" W. Pine S 08° E 13.04'

8" R. Pine S 37° W 7.55'

And is accepted as a careful and faithful perpetuation of the position of the original corner.

E-11/12

MC between Sec. 32 & 33.

Corner is 1 1/4" iron pipe with brass cap cemented to top.

10" R. Pine S 14° W 46.82'

6" W. Pine S 43° W 28.50'

16" W. Pine S 87° E 83.07'

NW cor. of foundation S 17° E

34.39'

And is accepted as a careful and faithful perpetuation of the position of the original corner.

Signed by John I. Haataja
Surveyor's Michigan License No. 19833

Date November 21, 1994