

LAND CORNER RECORDATION CERTIFICATE LIBER  
Filing Requirement of Act 74, Mich. P.A. 1970

2 PAGE 338  
STATE OF MICHIGAN  
COUNTY OF KALAMAZOO  
RECEIVED FOR RECORD  
'98 OCT 20 AM 11 25  
J. Smith  
CLERK - REGISTER  
Register of Deeds Stamp & File Number

KALAMAZOO  
(County)

	Located In:	Corner Code #
1. Public Land Survey	T 1S R 11W	D-7
	T R	
	T R	
	T R	
	T R	
2. Property Controlling in Section	S T R	
	S T R	
3. Miscellaneous Property in Sec.	S T R	
	S T R	

4. Lot No. , Recorded Plat

5. Private Claims

I, WILLIAM K. CRANE, P.S., in a field survey on September 23, 19 97 do hereby state that under requirements of P.A. 74, Michigan P.A. of 1970, the corner points mentioned in lines 1 and 2 above were in conformance with regulations and rules therefore as required in the current manual of survey instructions of the United States Department of the Interior, Bureau of Land Management or by a decree of a Court of Law and /or that the corner points mentioned in lines 3, 4 and 5 above were in conformance with the rules of the Michigan Board of Land Surveyors or by a Decree of a Court of Law; established, re-established, monumented, recovered, found as expressed below:

NOTE: Not more than 2 corners, all in the same town and range, may be recorded on this certificate.

A. Description of original monument and accessories and/or subsequent restoration:

G.L.O.:  
14" W.O., S.83°W, 59 LINKS  
15" W.O., S.73°E, 70 LINKS

E. STRONG, C.S., MARCH 1903:  
FOUND MARKED STONE  
GATE POST, S.3°E, 47 1/2.

E. STRONG, C.S., APRIL 1908:  
GATE POST, S.3°E, 47 1/2.  
FENCE, S. 49 1/2.

RECORDED SURVEY, LIBER 1, PAGE 6, JUNE 1971 (SURVEYOR UNKNOWN):  
3/4" IRON  
14" MAPLE, N.01°W, 23.9'  
36" ELM, S.20°W, 27.8'

B. Description of corner evidence found and/or method applied in restoring or reestablishing corner:

FOUND 3/4" IRON IN MONMENT BOX. DUG APPROXIMATELY 2.5 FEET AND FOUND LARGE STONE. SET HARRISON MARKER AND MONUMENT BOX OVER STONE.

C. Description of monument for corner and accessories established to perpetuate locating the position of the corner:

FOUND STONE IS ACCEPTED AS THE BEST AVAILABLE EVIDENCE OF THE POSITION OF THE ORIGINAL CORNER. RAISED STONE WITH HARRISON MARKER AND MONUMENT BOX.

SET NAIL IN E. SIDE OF 12" MAPLE, N.02°E, 31.53'  
S.W. CORNER OF HOUSE #2450, N.55°W, 228.01'  
SET NAIL IN N. SIDE OF 20" WALNUT, S.60°W, 147.85'  
SET "PK" IN E. SIDE OF U.P., S.83-1/2°W, 46.25'


Signed by William K. Crane  
William K. Crane, P.S.

Date 10/19/98

Surveyor's Michigan License No.: 29243

FORM APPROVED BY MICHIGAN STATE BOARD OF PROFESSIONAL SURVEYORS, JAN. 28, 1971

REVISED MAY 14, 1975  
REVISED JAN., 1983  
REVISED OCT., 1995

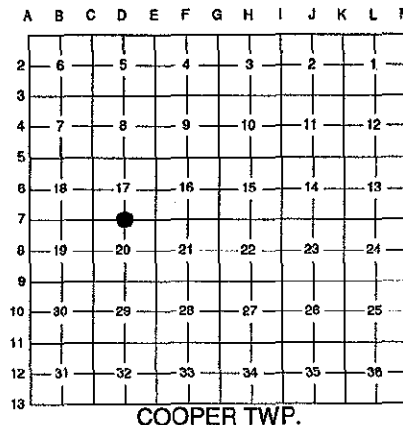

RATIFIED  
BY KALAMAZOO COUNTY  
REMONUMENTATION  
PEER GROUP  
3-19-1998  
R.V.

