

SURVEY & REMONUMENTATION

FEB 26 1998

LAND CORNER RECORDATION CERTIFICATE Filing Requirement of Act 74, Mich. P.A. 1970

LIBER

2 PAGE 225

For corners in

SECTION

KALAMAZOO
(County)

Located In: SEC. 31 Corner Code #

1. Public Land Survey

T 2 S R 10 W. A-13

2. Property Controlling
in Section

S T R

3. Miscellaneous
Property in Sec.

S T R

4. Lot No. _____, Recorded Plat _____
5. Private Claims _____

I, ROGER E. STEPHENSON, in a field survey on OCTOBER 29, 1996, do hereby state that under requirements of P.A. 74, Michigan P.A. of 1970, the corner points mentioned in lines 1 and 2 above were in conformance with regulations and rules therefore as required in the current manual of survey instructions of the United States Department of the Interior, Bureau of Land Management or by a decree of a Court of Law and /or that the corner points mentioned in lines 3, 4 and 5 above were in conformance with the rules of the Michigan Board of Land Surveyors or by a Decree of a Court of Law; established, re-established, monumented, recovered, found as expressed below:

NOTE: Not more than 2 corners, all in the same town and range, may be recorded on this certificate.

	A	B	C	D	E	F	G	H	I	J	K	L	M
1													
2	6		5		4		3		2		1		
3													
4	7		8		9		10		11		12		
5													
6	18		17		16		15		14		13		
7													
8	19		20		21		22		23		24		
9													
10	30		29		28		27		26		25		
11													
12	31		32		33		34		35		36		
13													

A. Description of original monument and accessories and/or subsequent restoration:

1827, ORIGINAL POSITION ESTABLISHED BY JOHN MULLET, D.S.

1885, TILE SET BY F. HODGEMAN

1960, I.W.M. CALLS FOR BOAT SPIKE
UNDATED - COUNTY SURVEYORS RECORDS INDICATE SAME

1964, I.W.M. CALLS FOR RING & IRON

1972, G.A.I. CALLS FOR RING & IRON
REFERENCE AT SW CORNER OF MANHOLE
AS N45°E, 62.86°.

B. Description of corner evidence found and/or method applied in restoring or reestablishing corner:

FOUND 1/2" IRON UNDER PAVEMENT


DUG 4'X4'X4' UNDER THE IRON AND FOUND NORTHING.
AT 4' DEEP ENCOUNTERED FILL MATERIAL.

C. Description of monument for corner and accessories established to perpetuate locating the position of the corner:

SET STANDARD MARKER IN PLACE OF FOUND 1/2" BAR

WITNESSES:
"+" ON MANHOLE, N43°53'E, 62.29'
PP, S48°E, 57.15'
STREET LIGHT, S52°W, 74.14'
CORNER OLD ENTRANCE, N36°W, 149.75'

RATIFIED
BY KALAMAZOO COUNTY
REMONUMENTATION
PEER GROUP
12-19-1996

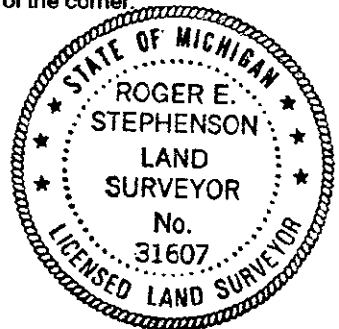

Signed by Roger E. Stephenson
Surveyor's Michigan License No. 31607

Date 10/23/97