

SURVEY &  
REMONUMENTATION  
LIBER

1 PC 1151

APR 27 1995

LAND CORNER RECORDATION CERTIFICATE  
Filing Requirement of Act 74, Mich. P.A. 1970

COMMISSION

For corners in

Kalamazoo  
(County)

Oshtemo Township

Located In:

Corner Code #

- |                                    |            |      |
|------------------------------------|------------|------|
| 1. Public Land Survey              | T 2S R 12W | E-13 |
|                                    | T R        |      |
|                                    | T R        |      |
|                                    | T R        |      |
| 2. Property Controlling in Section | S T R      |      |
|                                    | S T R      |      |
| 3. Miscellaneous Property in Sec.  | S T R      |      |
|                                    | S T R      |      |

CLERK-REGISTER

STATE OF MICHIGAN  
COUNTY OF KALAMAZOO  
RECEIVED FOR RECORD  
94 JUL 6 AM 11 52

Register of Deeds Stamp & File Number

4. Lot No. , Recorded Plat  
5. Private Claims

	A	B	C	D	E	F	G	H	I	J	K	L	M
2	6	5	4	3	2	1							
3													
4	7	8	9	10	11	12							
5													
6	18	17	16	15	14	13							
7													
8	19	20	21	22	23	24							
9													
10	30	29	28	27	26	25							
11													
12	31	32	33	34	35	36							
13													

I, Thomas W. Chettleburgh, in a field survey on January 31, 19 94, do hereby certify that under requirements of P.A. 74, Michigan P.A. of 1970, the corner points mentioned in lines 1 and 2 above were in conformance with regulations and rules therefore as required in the current manual of survey instructions of the United States Department of the Interior, Bureau of Land Management or by a decree of a Court of Law and/or that the corner points mentioned in lines 3, 4 and 5 above were in conformance with the rules of the Michigan Board of Land Surveyors or by a Decree of a Court of Law; established, re-established, monumented, re-monumented, recovered, found as expressed below:

**NOTE: Not more than 4 corners, all in the same town and range, may be recorded on this certificate.**

A. Description of original monument and accessories and/or subsequent restoration:

Corner Post set by U.S. Government Deputy Surveyor William Brookfield, 1827.  
Accessories: W Oak 8 N64E 1.32, Y Oak 11 N45W 1.30.  
Kalamazoo County Witness sheet, stone with cross.  
Peabody, 1981, Stone with cross, Recorded LCRC Liber 1, Page 824  
Accessories: Centerline Road East 89.85', 24" Oak East 61.8', P.Pole S35E 92.2'.


B. Description of corner evidence found and/or method applied in restoring or reestablishing corner:

Original Corner Post & Accessories not recovered.  
Found stone with cross as described and recorded by Peabody in 1981. The stone was accepted as a careful and faithful perpetuation of the position of the original corner and was ratified by the Kalamazoo County Remonumentation Program Peer Group on March 3, 1994.  
Replaced stone with 30" Harrison Monument.

RATIFIED  
BY KALAMAZOO COUNTY  
REMONUMENTATION  
PEER GROUP  
3-3-94

C. Description of monument for corner and accessories established to perpetuate locating the position of the corner:

30" Harrison Monument		
4" Diameter Harrison Monument (NW corner Sec. 4, T3S, R12W)	S 87°E	85.69'
Spike NE side Power Pole	S23°E	92.92'
SW Cor. garage foundation	N50°W	65.82'
SE Cor. garage foundation	N32°W	49.62'
Spike E. side 9" Oak	N0°E	24.37'
Spike S. side 32" Oak	S89°E	62.63'

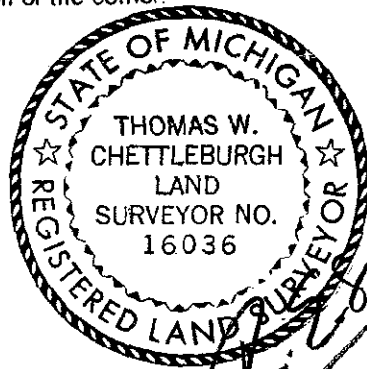

Signed by Thomas W. Chettleburgh  
Surveyor's Michigan License No. 16036

Date July 5, 1994