

APR 26 1996

COMMISSION

LAND CORNER RECORDATION CERTIFICATE
Filing Requirement of Act 74, Mich. P.A. 1970

For corners in

Kalamazoo
(County)

Located In:

Corner Code #

- | | | |
|------------------------------------|------------|-----|
| 1. Public Land Survey | T 3S R 12W | H-7 |
| | T R | |
| | T R | |
| | T R | |
| 2. Property Controlling in Section | S T R | |
| | S T R | |
| 3. Miscellaneous | S T R | |
| Property in Sec. | S T R | |

4. Lot No. _____, Recorded Plat _____
5. Private Claims _____

STATE OF MICHIGAN
COUNTY OF KALAMAZOO
RECEIVED FOR RECORD
95 NOV 22 AM 8 42
CLERK - ALGISTER

Register of Deeds Stamp & File Number

I, Thomas W. Chettleburgh, in a field survey on November 3, 1994, do hereby certify that under requirements of P.A. 74, Michigan P.A. of 1970, the corner points mentioned in lines 1 and 2 above were in conformance with regulations and rules therefore as required in the current manual of survey instructions of the United States Department of the Interior, Bureau of Land Management or by a decree of a Court of Law and/or that the corner points mentioned in lines 3, 4 and 5 above were in conformance with the rules of the Michigan Board of Land Surveyors or by a Decree of a Court of Law; established, re-established, monumented, re-monumented, recovered, found as expressed below:

NOTE: Not more than 4 corners, all in the same town and range, may be recorded on this certificate.

A. Description of original monument and accessories and/or subsequent restoration:

Corner Post set by U.S. Government Deputy Surveyor Thos Whelpley, 1829.

Accessory: 12" Taminac S 8 3/4 E 1.82 chains

Ed Strong 1870, Set stone from one witness

Accessories: 16" W Oak S 41 W 27 links, 4" Maple N 56 W 100 links

Ed Strong 1911, Found stone.

Smith & Smith 1960, Found corner.

Gilchrist 1980, Found iron bar in monument box, Record L.C.R.C. Liber 1, Page 816

Wilkins & Wheaton 1992, Restore iron in monument box after sewer construction.

B. Description of corner evidence found and/or method applied in restoring or reestablishing corner:

Original corner post and accessory not recovered.

Found iron in monument box as described and recorded by Gilchrist and as restored by Wilkins & Wheaton.

The iron in monument box was accepted as a careful and faithful perpetuation of the position of the original corner and was ratified by the Kalamazoo County Remonumentation Program Peer Group on December 15, 1994.

Replaced iron in monument box with 20" Harrison Monument.

	A	B	C	D	E	F	G	H	I	J	K	L	M
2	6	5	4	3	2	1							
3													
4	7	8	9	10	11	12							
5													
6	18	17	16	15	14	13							
7													
8	19	20	21	22	23	24							
9													
10	30	29	28	27	26	25							
11													
12	31	32	33	34	35	36							
13													

RATIFIED
BY KALAMAZOO COUNTY
REMONUMENTATION
PEER GROUP
12-15-94

C. Description of monument for corner and accessories established to perpetuate locating the position of the corner:

20" Harrison Monument in monument box.

Spike SE side 8" Maple N30 E 34.00'


Spike E side 13" Hickory S10 W 25.96'

Spike NW side 10" Pine S50 W 72.91'

Centerline 24" dia. manhole S85 W 31.97'

Spike W side 10" Maple N20 W 27.75'

Corner in centerline E-W pavement for "Q" Avenue

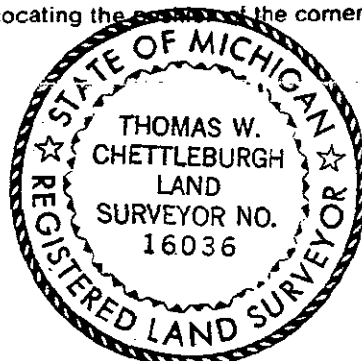

Signed by

Thomas W. Chettleburgh

Date

October 25, 1995

Surveyor's Michigan License No.

16036