



LC-000102
Page: 1 of 1
12/30/1999 08:38A
Bk-2 Pg-555

LAND CORNER RECORDATION CERTIFICATE
Filing Requirement of Act 74, Mich. P.A. 1970

For corners in

Kalamazoo Located In: Corner Code #
(County) Texas Twp

1. Public Land Survey T 3 S R 12 W L-1
T R
T R
T R
2. Property Controlling S T R
in Section S T R
3. Miscellaneous S T R
Property in Sec. S T R

SURVEY &
REMONUMENTATION

FEB 08 2000

SECTION

Register of Deeds Stamp & File Number

4. Lot No. _____, Recorded Plat _____
5. Private Claims _____

I, James E. Boynton, in a field survey on November 15, 1999 do hereby certify that under requirements of P.A. 74, Michigan P.A. of 1970, the corner points mentioned in lines 1 and 2 above were in conformance with regulations and rules therefore as required in the current manual of survey instructions of the United States Department of the Interior, Bureau of Land Management or by a decree of a Court of Law and /or that the corner points mentioned in lines 3, 4 and 5 above were in conformance with the rules of the Michigan Board of Land Surveyors or by a Decree of a Court of Law; established, re-established, monumented, re-monumented, recovered, found as expressed below:

NOTE: Not more than 4 corners, all in the same town and range, may be recorded on this certificate.

	A	B	C	D	E	F	G	H	I	J	K	L
1												
2		6		5		4		3		2		1
3												
4		7		8		9		10		11		12
5												
6		18		17		16		15		14		13
7												
8		19		20		21		22		23		24
9												
10		30		29		28		27		26		25
11												
12		31		32		33		34		35		36
13												

A. Description of original monument and accessories and/or subsequent restoration:

This corner not established by GLO. Ed Strong, County Surveyor found stone in 1909. W. D. Ingersoll, Surveyor, found stone in 1967. Ingersoll, Watson & McMachen found and referenced a drilled stone in 1985.

B. Description of corner evidence found and/or method applied in restoring or reestablishing corner:

Found drilled Stone from 1985 references 12" ± below surface and 31.89' East of South quarter post of Section 36, T2S, R12W. Dug the stone out and found nothing further.


C. Description of monument for corner and accessories established to perpetuate locating the position of the corner:

Accepted stone as the best available evidence of the position of the corner and placed 30" Harrison marker in place of stone as directed by the Peer Group at a meeting held on December 9, 1999.

New References:

Utility Pole S.80°E. 25.28' to nail
30" Oak S.30°W. 59.67' to nail
40" Oak S.77°W. 108.68' to nail
36" Oak N.30°E. 77.80' to nail

RATIFIED
BY KALAMAZOO COUNTY
REMONUMENTATION
PEER GROUP
12-09-1999

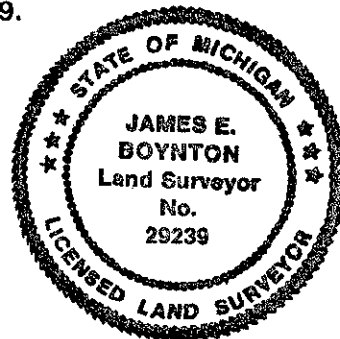

Signed by James E. Boynton
Surveyor's Michigan License No. 29239

Date 12-29-99