

SURVEY &
REMONUMENTATION

APR 27 1995

COMMISSION

LAND CORNER RECORDATION CERTIFICATE,
Filing Requirement of Act 74, Mich. P.A. 1970

STATE OF MICHIGAN
COUNTY OF KALAMAZOO
RECEIVED FOR RECORD

94 DEC 15 PM 1 36

For corners in Schoolcraft Twp.

Kalamazoo
(County)

Located In:

Corner Code ##

1. Public Land Survey T 4 S R 11 W K-8
T R
T R
T R
2. Property Controlling S T R
in Section S T R
3. Miscellaneous S T R
Property in Sec. S T R

James J. Jones
CLERK-REGISTER

LIBER 1 PG 1216

Register of Deeds Stamp & File Number

4. Lot No. , Recorded Plat
5. Private Claims


I, Allen H. McMachen, in a field survey on May 3, 19 94,
do hereby certify that under requirements of P.A. 74, Michigan P.A. of 1970, the corner points mentioned
in lines 1 and 2 above were in conformance with regulations and rules therefore as required in the
current manual of survey instructions of the United States Department of the Interior, Bureau of Land
Management or by a decree of a Court of Law and/or that the corner points mentioned in lines 3, 4 and 5
above were in conformance with the rules of the Michigan Board of Land Surveyors or by a Decree of a
Court of Law; established, re-established, monumented, re-monumented, recovered, found as
expressed below:

NOTE: Not more than 4 corners, all in the same town and range, may be recorded
on this certificate.

A. Description of original monument and accessories and/or subsequent restoration:

1800's - F. Hodgeman C.S. placed Clay Tile Post during
official Township Remonumentation.

	A	B	C	D	E	F	G	H	I	J	K	L	M
2	6	5	4	3	2	1							
3													
4	7	8	9	10	11	12							
5													
6	18	17	16	15	14	13							
7													
8	19	20	21	22	23	24							
9													
10	30	29	28	27	26	25							
11													
12	31	32	33	34	35	36							
13													

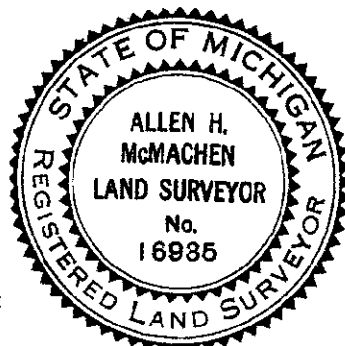

B. Description of corner evidence found and/or method applied in restoring or reestablishing corner:

Found Clay Tile at edge of Marsh.

RATIFIED
BY KALAMAZOO COUNTY
REMONUMENTATION
PEER GROUP

7/21/94

R. E. S.

C. Description of monument for corner and accessories established to perpetuate locating the position of the corner:

Found Clay Tile is accepted as a careful and faithful perpetuation
of the original corner. Placed Standard Sleeve over existing Tile,
Accessories:

2" Dia. steel test well N. 60° E. 24.68'
Nail & Tab in 8" Willow N. 30° E. 47.60'
Nail & Tab in 30" Oak East 46.68'
Nail & Tab in 10" Elm S. 75° E. 10.25'
Nail & Tab in 8" Elm S. 40° E. 30.00'

Signed by

Allen H. McMachen

Date

11/17/94

Surveyor's Michigan License No.

16935