

SURVEY &  
REMONUMENTATION

FEB 18 1994

COMMISSION

KALAMAZOO COUNTY REMONUMENTATION

LAND CORNER RECORDATION CERTIFICATE

Filing Requirement of Act 74, Mich. P.A. 1970

STATE OF MICHIGAN  
COUNTY OF KALAMAZOO  
RECEIVED FOR RECORD

93 NOV 11 AM 8 54

For corners in

Kalamazoo  
(County)

Located In:

Corner Code #

1. Public Land Survey T 4S R 12W E-2  
T     R     E 1/4 Cor.  
T     R     Sec. 5  
T     R     Prairie Ronde  
Township
2. Property Controlling S     T     R      
in Section S     T     R
3. Miscellaneous S     T     R      
Property in Sec. S     T     R

*James J. Gange*  
CLERK-REGISTER

LIBER

1 PG 1022

Register of Deeds Stamp & File Number

4. Lot No.            Recorded Plat
5. Private Claims

	A	B	C	D	E	F	G	H	I	J	K	L	M
2	6		5		4		3		2		1		
3													
4	7		8		9		10		11		12		
5													
6	13		17		16		15		14		13		
7													
8	19		20		21		22		23		24		
9													
10	30		29		28		27		26		25		
11													
12	31		32		33		34		35		36		
13													

Thomas W.

Chettleburgh

October 15

1993

I, Thomas W. Chettleburgh, in a field survey on October 15, 1993, do hereby certify that under requirements of P.A. 74, Michigan P.A. of 1970, the corner points mentioned in lines 1 and 2 above were in conformance with regulations and rules therefore as required in the current manual of survey instructions of the United States Department of the Interior, Bureau of Land Management or by a decree of a Court of Law and/or that the corner points mentioned in lines 3, 4 and 5 above were in conformance with the rules of the Michigan Board of Land Surveyors or by a Decree of a Court of Law; established, re-established, monumented, re-monumented, recovered, found as expressed below:

NOTE: Not more than 4 corners, all in the same town and range, may be recorded on this certificate.

A. Description of original monument and accessories and/or subsequent restoration:

Strong 1901, Found stone

W. Smith 1977, Found drilled stone, set Monument Box

B. Description of corner evidence found and/or method applied in restoring or reestablishing corner:

Found drilled stone in Monument Box in centerline 4th Street (gravel road)

Set 4" X 16" Harrison Monument over stone

RATIFIED  
BY KALAMAZOO COUNTY  
REMONUMENTATION  
PEER GROUP

C. Description of monument for corner and accessories established to perpetuate locating the position of the corner:

4" X 16" Harrison Monument in Monument Box

Spike NW side Power Pole

N57°E

29.16'

Spike SE side 30" Beech

S41°W

66.19'

Spike S side 14" Ash


S90°W

46.56'

Centerline S. Gate Post (steel pipe)

N23°W

85.92'

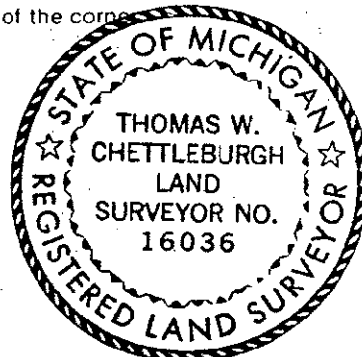

Signed by

*Thomas W. Chettleburgh*

Date

November 8, 1993

Surveyor's Michigan License No.

16036