

MAY 16 1997

COMMISSION

LAND CORNER RECORDATION CERTIFICATE
Filing Requirement of Act 74, Mich. P.A. 1970

LIBER003 PAGE0350

For corners in

Lake (County)	Located In:	Corner Code #
	17N 11W	c-5
1. Public Land Survey	T R	
	T R	
	T R	
	T R	
2. Property Controlling in Section	S T R	
	S T R	
3. Miscellaneous Property in Sec.	S T R	
	S T R	

RECORDED
LAKE COUNTY, MI.
SEP 12 3 07 PM '96
REGISTER OF DEEDS
J. J. J. J.

Register of Deeds Stamp & File Number

4. Lot No. _____, Recorded Plat _____
5. Private Claims _____

Robert L. Wetherell

August 6,

96

I, _____, in a field survey on _____, 19____, do hereby certify that under requirements of P.A. 74, Michigan P.A. of 1970, the corner points mentioned in lines 1 and 2 above were in conformance with regulations and rules therefore as required in the current manual of survey instructions of the United States Department of the Interior, Bureau of Land Management or by a decree of a Court of Law and/or that the corner points mentioned in lines 3, 4 and 5 above were in conformance with the rules of the Michigan Board of Land Surveyors or by a Decree of a Court of Law; established, re-established, monumented, re-monumented, recovered, found as expressed below:

NOTE: Not more than 4 corners, all in the same town and range, may be recorded on this certificate.

A. Description of original monument and accessories and/or subsequent restoration:

C-5 - Section corner common to Sections 7, 8, 17 & 18, T17N, R11, Chase Twp., Lake Co., Mi.

1838 - John Hodgson, G.L.O. - Deputy Surveyor

#1. - 10" Sugar N56°E 42 Links

#2. - 18" Sugar S46°W 33 Links

Undated - George Johnson, Co. Surveyor (1920's m/l)

Monument was a plow point

#3. - 22" Elm S6°30'W 43.3'

B. Description of corner evidence found and/or method applied in restoring or reestablishing corner:

C-5 - Section corner common to Sections 7, 8, 17 & 18, T17N, R11, Chase Twp., Lake Co., Mi.

Found dock spike over top of old plow point (2' deep) in centerline of roads East, West and South. Corner is in line with an old fence (down) running North. All of the above accessories were gone.

Measurements from this corner: To the E. 1/4 cor. Sec. 7 = 2651.99'

To the S. 1/4 cor. Sec. 7 = 2651.16'

To the S. 1/4 cor. Sec. 8 = 2640.18'

To the W. 1/4 cor. Sec. 17 = 2654.48'

RATIFIED BY THE LAKE CO. PEER REVIEW GROUP
IN ACCORDANCE WITH P.A. 345

CHAIRMAN

DATE 8-27-96

C. Description of monument for corner and accessories established to perpetuate locating the position of the corner:

C-5 - Section corner common to Sections 7, 8, 17 & 18, T17N, R11, Chase Twp., Lake Co., Mi.


I set a 3/4" x 24" re-bar with Lake County Brass Cap, directly over the plow point, and is accepted as a careful and faithful re-establishment of the position of the original corner.

Power Pole S46°E 107.06' (P.K. nail in S. side)

Power Pole S68°W 151.32' (P.K. nail in N. side)

6" Elm S27°W 174.35' (60d spike in W. side)

18" W. Pine N43°W 112.70' (60d spike in n. side)

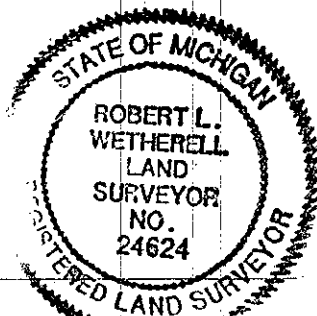

August 28, 1996

Signed by Robert L. Wetherell

Date

LS 24624

Surveyor's Michigan License No.