

STATE OF MICHIGAN
DEPARTMENT
OF
NATURAL RESOURCES
LAND CORNER RECORD


LAKE COUNTY
T 18 N R 12 W

DESCRIPTION OF CORNER South 1/4 corner - Section 7

CORNER MONUMENT Found 1/2" x 1/4" iron rod. Added DNR monument buried 8"

DATE MONUMENT PLACED AND WITNESSED 6-13-72

WITNESSES TO CORNER..... 8" B. Oak S 45 E 59.37

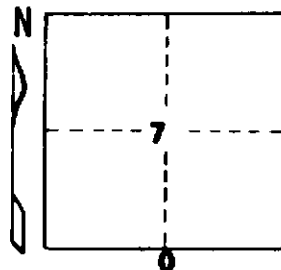


7" B. Oak S 03 W 46.53

AND

CIRCLE CORNER REGISTERED

DESCRIPTION IN DETAIL AS TO HOW CORNER WAS LOCATED AND IDENTIFIED OR RESTORED.

Found Bob Griffin corner of record.

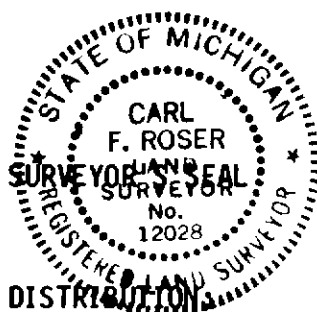

SIGNED

Carl F. Roser

REGISTERED LAND SURVEYOR

DATE

7-3-72

Forestry Division, Lansing