

NOV 15 1994

COMMISSION

LAND CORNER RECORDATION CERTIFICATE
Filing Requirement of Act 74, Mich. P.A. 1970

LIBER 003 PAGE 0234

For corners in

LAKE (County)	Located In:	Corner Code #
1. Public Land Survey	T 19N R 11W	I-13
	T R	
	T R	
	T R	
2. Property Controlling in Section	S T R	
	S T R	
3. Miscellaneous Property in Sec.	S T R	
	S T R	

RECORDED
LAKE COUNTY, MI.
OCT 7 3 47 PM '94
REGISTER OF DEEDS
J. H. H. H.

Register of Deeds Stamp & File Number

4. Lot No. _____, Recorded Plat _____
5. Private Claims _____

I, Robert L. Wetherell, in a field survey on May 26, 1994,
do hereby certify that under requirements of P.A. 74, Michigan P.A. of 1970, the corner points mentioned
in lines 1 and 2 above were in conformance with regulations and rules therefore as required in the
current manual of survey instructions of the United States Department of the Interior, Bureau of Land
Management or by a decree of a Court of Law and/or that the corner points mentioned in lines 3, 4 and 5
above were in conformance with the rules of the Michigan Board of Land Surveyors or by a Decree of a
Court of Law; established, re-established, monumented, re-monumented, recovered, found as
expressed below:

NOTE: Not more than 4 corners, all in the same town and range, may be recorded
on this certificate.

A. Description of original monument and accessories and/or subsequent restoration:

I-13 - (Section corner for Sections 34 and 35, T19N, R11W, on Township line).

1837 - John Hodgeson, D.S., G.L.O.
14" Birch Tree for corner
Northwest corner Section 2 - 65 Links East.

B. Description of corner evidence found and/or method applied in restoring or reestablishing corner:

I-13 - (Section corner for Sections 34 and 35, T19N, R11W, on Township line).


I was unable to locate the Birch Tree in "A" above or any other monument. I set the corner G.L.O. record distance
(42.90') West from the found closing corner (corner common to Sections 2 & 3, T18N, R11W). I set this corner on an
extension of the line from the N. 1/4 corner Section 2 (T18N, R11W) to the N.W. cor. of Sec. 2 (T18N, R11W) corner is
36 feet West of a North and South blacktop road.

C. Description of monument for corner and accessories established to perpetuate locating the position of the corner:

I-13 - (Section corner for Sections 34 and 35, T19N, R11W, on Township line).

I set a 3/4" x 24" re-bar with Lake County Brass Cap, and is accepted as a careful and faithful re-establishment of
the position of the original corner.

10" Maple S48°W 21.69' (60d spike in S.E. side of tree)
12" Maple N74°W 9.14' (60d spike in N. side of tree)
8" Cedar N14°E 27.85' (60d spike in E. side of tree)
(N.W. cor. Sec. 2, T18N, R11W) East 42.90' (Brass Cap Re-bar)

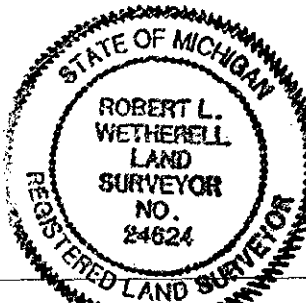

Signed by Robert L. Wetherell Date October 4, 1994
LS 24624

Surveyor's Michigan License No. _____

RATIFIED BY THE LAKE CO. PEER REVIEW GROUP
IN ACCORDANCE WITH P.A. 345
CHAIRMAN G. J. W.
DATE _____