

LAND CORNER RECORDATION CERTIFICATE
Filing Requirement of Act 74, Mich. P.A. 1970

For corners in
LAKE

(County)

Located In:

Corner Code ##

1. Public Land Survey

T 19N R 13W

T R

T R

T R

2. Property Controlling
in Section

S 1 T R

S T R

3. Miscellaneous
Property in Sec.

S 1 T R

S T R

* 701.8-6

OF M-1

Register of Deeds Stamp & File Number

4. Lot No. , Recorded Plat

5. Private Claims

I, CARL F. ROSER, in a field survey on 8/15, 19 85,
do hereby certify that under requirements of P.A. 74, Michigan P.A. of 1970, the corner points mentioned
in lines 1 and 2 above were in conformance with regulations and rules therefore as required in the
current manual of survey instructions of the United States Department of the Interior, Bureau of Land
Management or by a decree of a Court of Law and/or that the corner points mentioned in lines 3, 4 and 5
above were in conformance with the rules of the Michigan Board of Land Surveyors or by a Decree of a
Court of Law; established, re-established, monumented, re-monumented, recovered, found as
expressed below:

**NOTE: Not more than 4 corners, all in the same town and range, may be recorded
on this certificate.**

A. Description of original monument and accessories and/or subsequent restoration:

7

4

B. Description of corner evidence found and/or method applied in restoring or reestablishing corner:

7

4

FD 1/2" PIPE BY RLS, CLINT
COLE; SE COR OF S1/2 OF NE1/4
OF NE1/4 OF S-1. GLO SHOWN
80.00 CH ON E SIDE S-1 (W SIDE
S-6, T19N-R12W) AND SINCE E1/4
COR S-1 WAS REESTAB. M.O.L. (SP
TO GLO), OTHER SEC SPLITS ARE
SP ALSO. THE FD 1/2" PIPE IS
0.41-N & 0.16-W OF CALC
POSITION; ACCEPTED PIPE AS
FOUND. WINDING TWO TRACK RD (NW
-SE) IS 39'-N.


FD 1/2" PIPE BY RLS CLINT
COLE; NE COR OF S1/2 OF NE1/4
OF NE 1/4 OF S-1. GLO SHOWN
80.00 CH ON E SIDE OF S-1 (W
SIDE OF S-6, T19N-R12W) AND
SINCE E 1/4 S-1 WAS REESTAB.
M.O.L. (SP TO GLO), OTHER SEC
SPLITS ARE SP ALSO. THE FD
1/2" PIPE IS 0.15-N & 0.18-W
OF CALC POSITION; ACCEPTED
PIPE AS FD.

C. Description of monument for corner and accessories established to perpetuate locating the position of the corner:

FD 1/2" PIPE; ADDED CED POST
W/LOC TAG.

FD 1/2" PIPE; ADDED CED POST
W/LOC TAG.

8" W OAK	N55°E	10.1	10" W OAK	N05°W	24.1
8" R OAK	S15°E	23.3	13" W OAK	N70°W	15.9
5" W OAK	N65°W	15.3	19" B OAK	S10°W	2.5

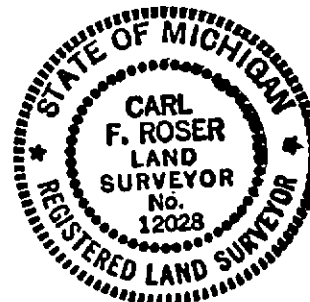

Signed by Carl F. Roser 01-27-88 Date

Surveyor's Michigan License No. 12028