

DEC 8 9 1993

SECTION

LAND CORNER RECORDATION CERTIFICATE  
Filing Requirement of Act 74, Mich. P.A. 1970

LIBER 004 PAGE 0160

For corners in  
Lake

(County)

Located in:

Corner Code #

20N

11W

1-12

1. Public Land Survey

T

R

T

R

T

R

T

R

2. Property Controlling  
in Section

S

T

R

S

T

R

3. Miscellaneous  
Property in Sec.

S

T

R

S

T

R

REGISTER OF DEEDS

*Shirley H. Hestand*

OCT 29 4 39 PM '98

RECORDED  
LAKE COUNTY, MI.

Register of Deeds Stamp & File Number

4. Lot No. \_\_\_\_\_, Recorded Plat \_\_\_\_\_  
5. Private Claims \_\_\_\_\_

Robert L. Wetherell

June 4, 98

I, \_\_\_\_\_, in a field survey on \_\_\_\_\_, 19\_\_\_\_ do hereby state that under requirements of P.A. 74, Michigan P.A. of 1970, the corner points mentioned in lines 1 and 2 above were in conformance with regulations and rules therefore as required in the current manual of survey instructions of the United States Department of the Interior, Bureau of Land Management or by a decree of a Court of Law and/or that the corner points mentioned in lines 3, 4 and 5 above were in conformance with the rules of the Michigan Board of Land Surveyors or by a Decree of a Court of Law; established, re-established, monumented, recovered, found as expressed below:

NOTE: Not more than 2 corners, all in the same town and range, may be recorded on this certificate.

	A	B	C	D	E	F	G	H	I	J	K	L	M
1													
2		6		5		4		3		2		1	
3													
4		7		8		9		10		11		12	
5													
6		18		17		16		15		14		13	
7													
8		19		20		21		22		23		24	
9													
10		30		29		28		27		26		25	
11													
12		31		32		33		34		35		36	
13													

A. Description of original monument and accessories and/or subsequent restoration:

I-12 - 1/4 Corner common to Sections 34 & 35, T20N, R11W, Lake Co., Mi.

1838 - S. Sibley, G.L.O.

#1 - 24" Hemlock S74°E 9 Links

#2 - 10" Hemlock N74°W 10 Links

1905 - J.W. Nicholson, Co. Sur.

"Identified & Re-established"

#3 - 10" Hemlock S3-1/4°E 47 Links

#4 - Sugar N79°W 43 Links

1915 - G.H. Johnson, Co. Sur.

1" Rod Iron (30" Long)

"Old witness down"

#5 - 14" Maple N50°E 82'

(SEE OVER FOR CONTINUATION OF "A")

B. Description of corner evidence found and/or method applied in restoring or reestablishing corner.

RATIFIED BY THE LAKE CO. PEER REVIEW GROUP  
IN ACCORDANCE WITH P.A. 345  
CHAIRMAN *R.L.W.*  
DATE 10-27-98

I-12 - 1/4 Corner common to Sections 34 & 35, T20N, R11W, Lake Co., Mi.

I found a 1" round iron, 30" long.

Condition of the accessories are as follows: #1 Gone, #2 Gone, #3 Gone, #4 Found 18" Maple (hollow), #5 Gone, #6 Found in good condition, #7 Found in good condition, #8 Found in good condition, #9 Found in good condition.

C. Description of monument for corner and accessories established to perpetuate locating the position of the corner.

I-12 - 1/4 Corner common to Sections 34 & 35, T20N, R11W, Lake Co., Mi.

I replaced the 1" round iron with a 3/4" x 24" re-bar with Lake County Brass Cap, and is accepted as a careful and faithful perpetuation of the position of the original corner.

20" Tw. Maple N84°E 19.72' (60d spike in N. side) #6

10" Hemlock S84°W 10.78' (60d spike in S. side) #7


10" Maple S15°E 22.85' (60d spike in E. side) #8

8" Hemlock S28°W 16.75' (60d spike in E. side) #9

Signed by *Robert L. Wetherell*

Surveyor's Michigan License No. 24624

Date 10-29-98

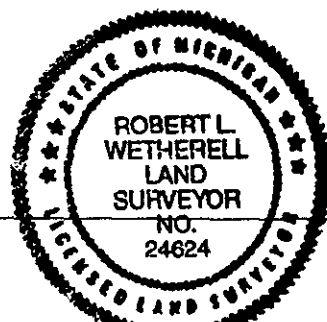

DEC 29 1993

SHEET 15

LIBER004 PAGE0161

CONTINUATION OF "A" - DESCRIPTION OF ORIGINAL MONUMENT AND ACCESSORIES AND/OR SUBSEQUENT RESTORATION:

1956 - W. Wright, Sur. & Eng.

Developed the plat of "Pine River Hills".

No corner description given

1975 - Clinton E. Cole, LS 17615

Survey recorded Liber 01, Pg. 637

#6 - 8" Tw. Maple N84°E 18.98'

#7 - 8" Hemlock S84°W 10.80'

#8 - 8" Maple S15°E 22.85'

1990 - Dwayne Wood, LS 24624

1" Pipe

#6 - 8" Tw. Maple AZ 84° 18.98'

#7 - 8" Hemlock AZ 264° 10.80'

#8 - 8" Maple AZ 165° 22.85'

1997 - Craig Pullen, PS 39095

#6 - 8" Tw. Maple N84°E 19.72'

#7 - 8" Hemlock S84°W 10.78'

#8 - 8" Maple S15°E 22.85'

#9 - 6" Hemlock S28°W 16.75'