

LAND CORNER RECORDATION CERTIFICATE

FILING REQUIREMENT OF ACT 74, MICH. P.A.1970

| FOR CORNERS OF:- | LOCATED IN:- | CORNER CODE NUMBER |
|---|--------------------|--------------------|
| 1. PUBLIC LAND SURVEY..... | T. 20 N. R. 12 W. | M-5; M-4; L-3; I-4 |
| 2. PROPERTY CONTROLLING IN SECTION..... | T. S. R. E. W. | |
| 3. MISCELLANEOUS PROPERTY IN SECTION..... | T. S. R. E. W. | |
| 4. LOT NO. | RECORDED PLAT..... | |
| 5. PRIVATE CLAIMS..... | | |

REGISTER OF DEEDS STAMP AND FILING NUMBER

I, CARL F. ROSER, do hereby certify that under requirements of P.A. 74, Michigan P.A. of 1970, the corner points mentioned in lines 1 and 2 above were, in a field survey on JUNE 29, 1981, established, re-established, monumented, re-monumented, recovered or restored as expressed below and in conformance with regulations and rules therefore as required in the current manual of survey instructions of the United States Department of the Interior, Bureau of Land Management or by a decree of a court of law. Furthermore, that the corner points mentioned in lines 3, 4 and 5 above were, in a field survey on _____, 19____, found, recovered, restored, established or re-established as expressed below and in conformance with the rules of the Michigan State Board of Registration for Land Surveyors or, by a Decree of a Court of law:

C. CONTINUED

| | | | | | |
|--|-------|--------|--|-------|-------|
| XX | | | XX | | |
| M-4 | | | L-3 | | |
| SET 5/8"X 36" RE-ROD W/RLS CAP #12028 | | | SET DNR MON & CED POST | | |
| 12" W. PINE | N40°E | 57.90' | 7" MAPLE | N10°W | 29.5' |
| COR FN POST | S80°E | 24.02' | 12" R. PINE | S15°W | 64.0' |
| 9" W. PINE | S50°E | 46.00' | 12" R. PINE | S35°W | 49.7' |
| CTR N-S BIT. TOP RD DUE W | | 8' | CTR CROOKED E-W TR DUE S | | 87' |
| SET CED POST W/LOC TAG | DUE E | 33' | | | |

B. Description of corner evidence found and/or method applied in restoring or re-establishing corner:

M-5 FD 3/4" PIPE OVER 2" I.D. PIPE, SAID 2" PIPE BEING BURIED 1 FT. COR FALLS ON EASTERLY EDGE OF N-S BIT. SURFACE RD.

M-4 RE-ESTABLISHED E 1/4 COR OF S-12 ON LINE ACROSS THE SE COR OF S-12 & THE NE COR OF S-1 AND ON LINE ACROSS THE W 1/4 COR OF S-12 & THE E 1/8 COR ON E-W 1/4 LINE OF S-12; SEE WORKING DRAWING SHEET 4 OF 4. FN EASTERLY IS SOUTH, TWO FEET. FN REMAINS WESTERLY (MOSTLY DOWN) ARE 5' (±3') SOUTH.

L-3 RE-ESTABLISH N 1/4 COR OF S-12 EQUIDISTANT & ON LINE BETWEEN THE NE & NW COR'S OF S-12. COR SET ON WEST END OF TRUE LINE SEC LINE CUT-IN FROM EAST.

I-4 FD 1" PIPE ON NW'LY SIDE OF OLD 27" W. PINE STUMP AND THREE OLD GEO. JOHNSON B.T.'S. U.S.(GLO) NOTES CALL FOR 30" PINE FOR CORNER.

C. Description of monument for corner and accessories established to perpetuate locating the position of the corner:

| | | | | | |
|------------------------|-------|---------|--|-------|-------|
| M-5 | | | I-4 | | |
| FD 3/4" PIPE | | | FD 1"X 21" PIPE ON NW'LY SIDE OLD 27" W. PINE STP; | | |
| 6" W. PINE | N60°W | 62.88' | ADDED DNR MON. & CED POST | | |
| 12" S. MAPLE | N30°W | 101.40' | 11" R. PINE | N65°W | 29.2' |
| CTR N-S BIT TOP RD | WEST | 7.5' | 11" W. OAK | S70°E | 21.0' |
| CTR GRAVEL RD. EAST | NORTH | 4' | 3" W. PINE | S35°E | 42.8' |
| CTR GRAVEL RD WEST | SOUTH | 3' | CTR E-W DIRT RD DUE N | | 175' |
| SET CED POST W/LOC TAG | N45°E | 47' | | | |

SIGNED BY Carl F. Roser 04-06-82 DATE

SURVEYOR'S MICHIGAN REGISTRATION NO. 12028


FOR STATE AND UNITED STATES AGENCIES:

SIGNED BY _____ DATE _____

APPROVED AND SIGNED BY _____ DATE _____

CHIEF OF SURVEY PARTY

MICHIGAN REGISTERED LAND SURVEYOR

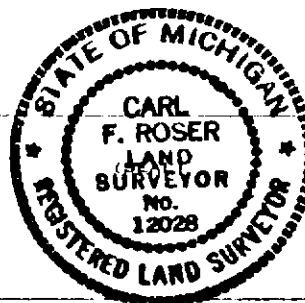

(SEAL)

SURVEYOR'S MICHIGAN REGISTRATION NO. _____

LAKE COUNTY