

SURVEY &
REMONUMENTATION

MAR 13 1998

SECTION

LAND CORNER RECORDATION CERTIFICATE
Filing Requirement of Act 74, Mich. P.A. 1970
ATTICA TOWNSHIP

RECEIVED FOR RECORD

98 JAN -7 PM 2: 55

For corners in

LAPEER
(County)

Located In:

Corner Code #

1. Public Land Survey

T 7 N R 11 E

M-2

T R

T R

T R

2. Property Controlling
in Section

S

T R

S

T R

3. Miscellaneous
Property in Sec.

S

T R

S

T R

4. Lot No. , Recorded Plat

5. Private Claims

I, WILLIAM E. SODERBERG, in a field survey on May 7, 19 97 do hereby certify that under requirements of P.A. 74, Michigan P.A. of 1970, the corner points mentioned in lines 1 and 2 above were in conformance with regulations and rules therefore as required in the current manual of survey instructions of the United States Department of the Interior, Bureau of Land Management or by a decree of a Court of Law and /or that the corner points mentioned in lines 3, 4 and 5 above were in conformance with the rules of the Michigan Board of Land Surveyors or by a Decree of a Court of Law; established, re-established, monumented, re-monumented, recovered, found as expressed below:

NOTE: Not more than 4 corners, all in the same town and range, may be recorded on this certificate.

A. Description of original monument and accessories and/or subsequent restoration:

1. GLO 1822	Joseph Wampler	Set post	No witnesses remain
2. Survey 5/18/84	R. Kay #14096	L6, P.704	Found 1/2" Iron
3. Survey 8/30/88	L. Bates #16699	L.8, P.31	Found 1/2" Iron
4. Survey 2/20/89	H. Elrich #18986	L.8, P.326	Found 1/2" Iron
5. Survey 11/13/91	H. Elrich #18986	L.9, P.591	Found 1/2" Iron
6. Survey 2/17/92	H. Elrich #18986	L.9, P.783	Found 1/2" Iron

B. Description of corner evidence found and/or method applied in restoring or reestablishing corner:

Found a 1/2" rebar in center of Summers Road (gravel) to the North and South
No occupation to the West.

Witness found: From items 2, 3, 4 5 and 6, S.20° W 61.90' West end 18" CMP
S.20°E. 59.30 East end 18" CMP
N20°w 98.65' Nail 8" Ash

Distances: M-1 to M-2 2881.50 feet GLO 40 chs M-2 to A-2 Imlay 77.00 feet
M-2 to M-3 2668.23 feet GLO 40 chs


C. Description of monument for corner and accessories established to perpetuate locating the position of the corner:

We placed a standard Lapeer County Remonumentation Brass cap on the found 1/2" rebar stamped #17635 as the best location for this corner as accepted by the Professional Surveyors in this area.

West 33.00 Found Iron/cap 18986
N. 10° W. 98.70' Set PK/Lapeer County remon tag in Southwest face utility pole
N. 75° E. 34.87 Set PK/Lapeer County remon tag in Northwest face utility pole
S. 20° E. 60.82' Notch East end 18" Culvert
S. 25° W. 61.66' Notch West end 18" culvert
South 77.00 Iron Remon cap for A-2 Imlay Township

Signed by William E. Soderberg December 15, 1997

Surveyor's Michigan License No. 17635

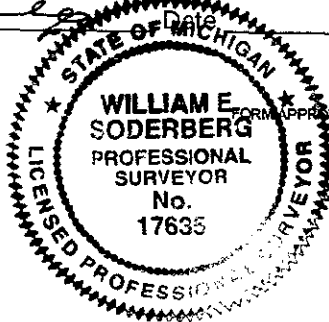

TEER GROUP
APPROVED LAND CORNER
PA 045 OF 1990
LAPPEER COUNTY
WILLIAM E. SODERBERG
MAY 1997 P.E. CO. SURVEYOR
DATE 10-15-97

LIBER 0006 PAGE 0005