

MAY 16 1997

COMMISSION

Filed under Remonumentation Act 345 of 1990

LAND CORNER RECORDATION CERTIFICATE

Filing Requirement of Act 74, Mich. P.A. 1970 LIBER 1 PAGE 160

For corners in

Lenawee

(County)

Located In:

Corner Code #

STATE OF MICHIGAN
LENAAEE COUNTY
FILED

17 DEC 96 9:20 A.M.

JEANETTE D. KNOX
REGISTER OF DEEDS

Register of Deeds Stamp & File Number

1. Public Land Survey

T-6-S R-4-E

T-7-S R-4-E

T- R-

T- R-

2. Property Controlling
in Section

S- T- R-

S- T- R-

3. Miscellaneous
Property in Sec

S- T- R-

S- T- R-

A-13
A-7

4. Lot No. , Recorded Plat

5. Private Claims

A B C D E F G H I J K L M

1													
2	6	5	4	3	2	1							
3													
4	7	8	9	10	11	12							
5													
6	18	17	16	15	14	13							
7													
8	19	20	21	22	23	24							
9													
10	30	29	28	27	26	25							
11													
12	31	32	33	34	35	36							
13													

I, Glenn E. Richard, in a field survey on October 31 19 96,

do hereby certify that under requirements of P.A. 74, Michigan P.A. of 1970, the corner points mentioned in lines 1 and 2 above were in conformance with regulations and rules therefore as required in the current manual of survey instructions of the United States Department of the Interior, Bureau of Land Management or by a decree of a Court of Law and/or that the corner points mentioned in lines 3, 4 and 5 above were in conformance with the rules of the Michigan Board of Land Surveyors or by a Decree of a Court of Law; established, re-established, monumented, re-monumented, recovered, found as expressed below:

NOTE: Not more than 4 corners, all in the same town and range, may be recorded on this certificate.

A. Description of original monument and accessories and/or subsequent restoration:

G.L.O. 1819, Joseph Fletcher Intersect W. Bdy & set post for corner of T6 & 7S-R4E, Hickory 10 S 5 E 17, W. Oak 16 S 61 W 34

1882 James Blair record "The corner had been destroyed in grading the highway. T.M. Carnahan was sworn and pointed out the location of said destroyed corner & Mr. Clapp gave the distance from E 1/4 cor., Sec. 36, T6S-R3E. I then measured the distance and it agreed with the place sworn to by T.M. Carnahan. I drove down an iron and placed bricks around it"

1940 Consumer Power Co. surveyors found iron & brick 2 1/2' below surface & set a 1" X 24" iron on top and put bricks and concrete around.

1941, Harold Clegg (W.E.F. employee) found gas pipe and it checked one of Blair's witnesses.

19067, Jack Gillin (Lenawee Co. Road Commission employee) found large bolt above 1 1/2" iron pipe & set monument box.

1987 Wanke tied to this corner while traversing around Sec. 6, Palmyra Twp.

B. Description of corner evidence found and/or method applied in restoring or reestablishing corner:

September 26, 1996, I found P.K. nail 2" deep over monument box 6" under the pavement surface and large sq. hd. bolt in the monument box. Dug out the box and found 1" iron pipe 2' deep.

October 21, 1996, I set 3/4" X 3' gas pipe in the pavement on the town line 4.30' East of the found corner.

October 31, 1996, I set a monument box over the gas pipe. I set on 10-21-96 in newly laid asphalt pavement.

This is a common corner with A-1, T7S-R4E.

C. Description of monument for corner and accessories established to perpetuate locating the position of the corner:

3/4" X 3' gas pipe capped G.E.R. 13040 in monument box and is accepted as the best available evidence of the position of the original corner.

Dbl. hd. nail & disc in 14" Hickory N 5° W 62.20

Dbl. hd. nail & disc in 30" Pine N 65° E 111.20


Dbl. hd. nail & disc in 8" Pine S 10° W 119.47

"X" cut in face of East 9" steel gate post N 20° E 94.64

N. edge of "T" rail guard post for RR. crossing sign S 85° E 262.84

Edge of MH N 45° E 2.26

Harrison monument at M-12, T6S-R3E North 289.20

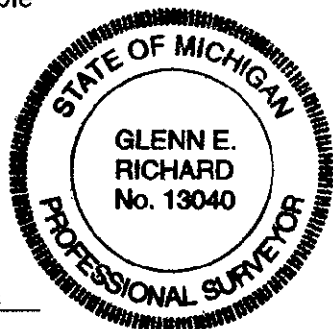

Ratified by Peer Group in accordance with P.A. 345 Co. Rep. Glenn E. Richard Date 10-08-1996

Signed by Glenn E. Richard Date 12-11-96
Glenn E. Richard

Surveyor's Michigan License No. 13040

FORM APPROVED BY MICHIGAN STATE BOARD OF LAND SURVEYORS, JAN. 28, 1971

REVISED MAY 14, 1975

REVISED JAN., 1983

ADAPTED FOR WORD PROCESSING MARCH, 1993