

LAND CORNER RECORDATION CERTIFICATE
Filing Requirement of Act 74, Mich. P.A. 1970 as Amended

For corners in

<u>Luce</u> (County)	Located In:	Corner Code #
1. Public Land Survey	T R	
	T R	
	T R	
2. Property Controlling in Section	S 21 T 45N R 11W	2
	S T R	(GCDB 360400)
	S 21 T 45N R 11W	9
	S T R	(GCDB 360340)
3. Miscellaneous Property in Sec.	S T R	
	S T R	
4. Lot No. _____, Recorded Plat		
5. Private Claims		

Register of Deeds Stamp & File Number

	A	B	C	D	E	F	G	H	I	J	K	L	M
1													
2	6		5		4		3		2		1		
3													
4	7		6		5		4		3		2		1
5													
6	18		17		16		15		14		13		
7													
8	19		20		21		22		23		24		
9													
10	30		29		28		27		26		25		
11													
12	31		32		33		34		35		36		
13													

I, Stephan J. Szyszkoski, in a field survey on 03/31/14 do hereby state
that under requirements of P.A. 74, Michigan P.A. of 1970, the corner points mentioned in lines 1 and 2
above were in conformance with regulations and rules therefore as required in the current manual of survey
instructions of the United States Department of the Interior, Bureau of Land Management or by a decree of
a Court of Law and /or that the corner points mentioned in lines 3, 4 and 5 above were in conformance with
the rules of the Michigan Board of Land Surveyors or by a Decree of a Court of Law; established,
re-established, monumented, recovered, found as expressed below:

NOTE: Not more than 2 corners, all in the same town and range, may be recorded
on this certificate.

A. Description of original monument and accessories and/or subsequent restoration:

(2-Sec. 21) East 1/16 corner between Sections 16 and 21. Not previously monumented.

(9-Sec. 21) Center-East 1/16 corner, Section 21. Not previously monumented.

B. Description of corner evidence found and/or method applied in restoring or reestablishing corner:


(2-Sec. 21) Established the position for the corner midway and on the Section line between Quarter
corner 1352.55' west and Section corner 1352.55' east.

(9-Sec. 21) Established the position for the corner midway and on a straight line between Quarter
corner 1342.55' east and the Center of Section 21 1342.55' west.

C. Description of monument for corner and accessories established to perpetuate locating the position of the corner:

(2) Set 1"IDx36" I.pipe with 2" alum. MDNR cap.
Set measuring nail with MDNR tag in the side of:
12" Hemlock S52°E 31.6' mrkd "E1/16 BT"
10" Sugar S08°E 17.15' do
6" Hemlock N76°W 9.4' do
12" W.Spruce N33°W 9.0' do
E= 8101558.790 N= 168137.064

(9) Set 1"IDx36" I.pipe with 2" alum. MDNR cap.
Set measuring nail with MDNR tag in the side of:
10" Maple S31°W 21.1' mrkd "E1/16 BT"
14" Maple S61°W 17.05' do
7" Sugar N05°E 19.8' do
6" Sugar S54°E 10.0' do
E= 8101573.359 N= 167334.352

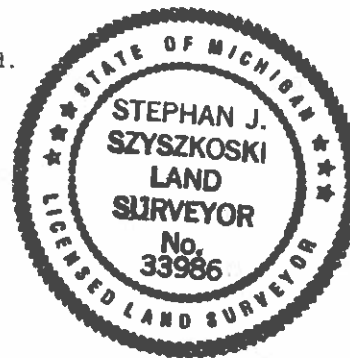

Bearings are magnetic. Coordinates are MCS83 in meters (NAD83(2011) Datum).
Coord. Ref.=NGS PID D08495: N= 169938.252 m. E= 8114556.094 m.

Signed by Stephan J. Szyszkoski
Surveyor's Michigan License No. 33986

Date 04/21/2014

For the Michigan Department of Natural Resources, Forest Resources Division