

SURVEY &
REMONUMENTATION

APR 07 1998 LAND CORNER RECORDATION CERTIFICATE
Filing Requirement of Act 74, Mich. P.A. 1970
Luce County Remonumentation Corner

For corners in SECTION

Luce County

Located in:

Corner Code #

1. Public Land Survey

T45N R11W

C-6 / C-7

T R

T R

T R

2. Property Controlling
in Section

S

T R

S

T R

3. Miscellaneous
Property in Sec.

S

T R

S

T R

4. Lot No. , Recorded Plat

5. Private Claims


LUCE COUNTY

REGISTER OF DEEDS

Recorded

Liber 3 page 769
02-24-1998 14:45:12
Kathy S. Mahar, Register
REGISTER OF DEEDS

Register of Deeds Stamp & File Number

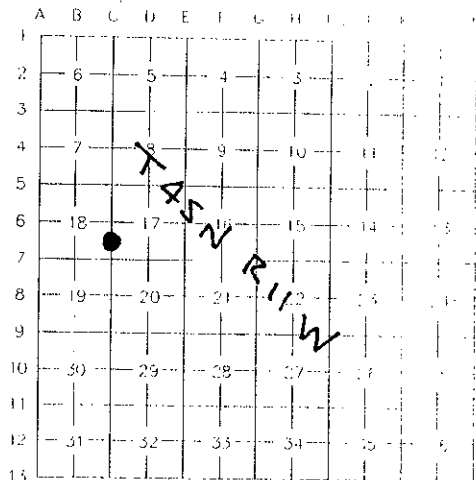

I, William L. Karr, in a field survey on December 19, 1997, do hereby state that under requirements of P.A. 74, Michigan P.A. of 1970, the corner points mentioned in lines 1 and 2 above were in conformance with regulations and rules therefore as required in the current manual of survey instructions of the United States Department of the Interior, Bureau of Land Management or by a decree of a Court of Law and /or that the corner points mentioned in lines 3, 4 and 5 above were in conformance with the rules of the Michigan Board of Land Surveyors or by a Decree of a Court of Law; established, re-established, monumented, recovered, found as expressed below:

NOTE: Not more than 2 corners, all in the same town and range, may be recorded on this certificate.

A. Description of original monument and accessories and/or subsequent restoration:

(C-6 / C-7) Meander Corner Common to Sections 17 and 18, T. 45 N., R. 11 W.

1849 William Ives set a post on the North shore of Manistique Lake 2 chains South of the 1/4 corner.

Witnesses: 10" Spruce N 75° E 5 lks
8" Cedar N 20° W 9 lks

Could find no subsequent survey history on this corner in available public records.

B. Description of corner evidence found and/or method applied in restoring or reestablishing corner:

(C-6 / C-7) Meander Corner Common to Sections 17 and 18, T. 45 N., R. 11 W.

This corner is being perpetuated as part of the Luce County Remonumentation Program.

Found no evidence of the original corner or subsequent restoration.

Reestablished the corner by extending section line 17/18 South from the 1/4 corner the record GLO distance, 132.00'.

C. Description of monument for corner and accessories established to perpetuate locating the position of the corner:

(C-6 / C-7) Meander Corner Common to Sections 17 and 18, T. 45 N., R. 11 W.

Corner is a 1/2" x 48" re-bar with a stamped aluminum Luce County Remonumentation cap. The corner falls 7' North of the top of bank on the North shore of North Manistique Lake and 132.00' South of the 1/4 corner.

Witnesses: 5" Cedar N 36° E 3.08'
8" Cedar N 61° E 27.80'
6" Cedar N 89° E 7.19'
5" Cedar N 50° W 9.15'

Bearings are compass bearings, corrected for declination (6°W), all distances are to a nail and tag in the side of the witness object unless otherwise noted.

Signed by William L. Karr

Date 12/22/97

Surveyor's Michigan License No. 27450