

LAND CORNER RECORDATION CERTIFICATE

FILING REQUIREMENT OF ACT 74, MICH. P.A. 1970

LUCE CO.

1 CORNER

FOR CORNERS OF--	LOCATED IN--	CORNER CODE NUMBER
1. PUBLIC LAND SURVEY	T. _____ S., R. _____ E. _____ W.	_____
2. PROPERTY CONTROLLING IN SECTION	7, T. 49, R. 10, N. 8, E. _____ W.	10
3. MISCELLANEOUS PROPERTY IN SECTION	T. _____ S., R. _____ E. _____ W.	_____
4. LOT NO. _____, RECORDED PLAT _____		
5. PRIVATE CLAIMS _____		

REGISTER OF DEEDS STAMP AND FILING NUMBER

I, Gerald L. Wiggins, do hereby certify that under requirements of P.A. 74, Michigan P.A. of 1970, the corner points mentioned in lines 1 and 2 above were, in a field survey on 9-30, 1985, established, re-established, monumented, re-monumented, recovered or restored as expressed below and in conformance with regulations and rules therefore as required in the current manual of survey instructions of the United States Department of the Interior, Bureau of Land Management or by a decree of a court of law. Furthermore, that the corner points mentioned in lines 3, 4 and 5 above were, in a field survey on _____, 19____, found, recovered, restored, established or re-established as expressed below and in conformance with the rules of the Michigan State Board of Registration for Land Surveyors or, by a Decree of a Court of law:

A. Description of original monument and accessories and/or subsequent restoration:

- 10 South 1/16 Corner on West side of Section 7. Corner set by Frank J. Bray L.S. on 6/1/65. 9" J. Pine, S19°W, 55½ lks. & 14" Y. Pine, N48°E, 61 lks. & 2" Iron Pipe, N69°W, 11 lks.


B. Description of corner evidence found and/or method applied in restoring or re-establishing corner:

- 10 Re-witt. and replaced pipe at corner as set by Bray on 6-1-65.

C. Description of monument for corner and accessories established to perpetuate locating the position of the corner:

- DNR Monument. 10 14" Y. Pine, N48°E, 40.26'
2" Iron Pipe, N69°W, 7.26'
8" R. Pine, N80°E, 63.2'
6" W. Birch, S6°E, 68.0'

SIGNED BY Gerald L. Wiggins DATE 9-10-86
SURVEYOR'S MICHIGAN REGISTRATION NO. 23521

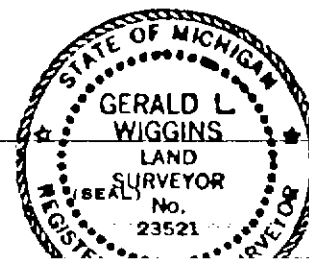

FOR STATE AND UNITED STATES AGENCIES: