

# SURVEY & EMONUMENTATION

MAR 13 2000

## SECTION

## LAND CORNER RECORDATION CERTIFICATE Filing Requirement of Act 74, Mich. P.A. 1970

For corners in

Luce  
(County)

Located In:

Corner Code #

1. Public Land Survey

T50N R12W

A 11-12 ✓ #1

T50N R13W

M 11-12

T R

T R

2. Property Controlling  
in Section

S

T R

S

T R

3. Miscellaneous  
Property in Sec.

S

T R

S

T R

4. Lot No. \_\_\_\_\_, Recorded Plat \_\_\_\_\_

5. Private Claims \_\_\_\_\_

LUCE COUNTY  
REGISTER OF DEEDS  
Recorded

*Liber 3 Page 918*

02-08-2000 13:04:52

*Kathy S. Mahar*  
Kathy S. Mahar, Register

REGISTER OF DEEDS

Register of Deeds Stamp & File Number

I, Robert L. Jamros, in a field survey on September 11, 1998, do hereby state that under requirements of P.A. 74, Michigan P.A. of 1970, the corner points mentioned in lines 1 and 2 above were in conformance with regulations and rules therefore as required in the current manual of survey instructions of the United States Department of the Interior, Bureau of Land Management or by a decree of a Court of Law and/or that the corner points mentioned in lines 3, 4 and 5 above were in conformance with the rules of the Michigan Board of Land Surveyors or by a Decree of a Court of Law, established, re-established, monumented, recovered, found as expressed below:

NOTE: Not more than 2 corners, all in the same town and range, may be recorded on this certificate.

A. Description of original monument and accessories and/or subsequent restoration:

M11-12: P.L.S. - John Burt, DS, 1841. Intersect Lake Superior. N. Pine 6, Meander Corner. N. Pine 9, S.18°E., 47 links, N. Pine 6, S.48°W., 43 links. \*\*\*\*\* Billy D. Buckler, RLS, 1975. Witness to meander set on the township line, extended from the South at 1364.0 feet North of the quarter corner. Record = 1568.8 feet. Erosion has moved bluff inland 200 feet. Witnesses, 8" J. Pine, S.41°W., 44.7 feet and 8" J. Pine, S. 23°E., 33.9 feet. Corner is 20 feet South of top of bluff. \* Unrecorded restoration. \*\*\*\*\* No other record of restoration.

B. Description of corner evidence found and/or method applied in restoring or reestablishing corner:

M11-12: Search made for witness to meander corner and reference trees of the 1975 restoration. All were lost to erosion. Witness to meander corner set on the township line, extended from the South at 1156.4 feet North of the quarter corner. Record = 1568.8 feet. Erosion has moved the bluff inland 283 feet. Set monument and established new reference trees. Corner as monumented is accepted as a careful and faithful witness to the position of the original corner.


C. Description of monument for corner and accessories established to perpetuate locating the position of the corner:

MC-1: Set witness corner, Bernsten aluminum monument with 3 1/4" aluminum cap no. AINB30, stamped to locate and identify witness corner position - 412.4 feet South of meander corner position. Established the following reference trees with BT signs, blazed, scribed and painted. Set PK nails for measure with aluminum I.D. washers in the following. \* Jack Pine 10", S.87°E., 5.40 feet, "WC S31 BT"; \* Jack Pine 8", S.20°W., 25.00 feet, "WC S36 BT". \* Survey marker sign on 6 foot steel post, N.50°E., 1.0 feet. Corner is 128 feet South of top of bluff. All bearings are magnetic.


Signed by

Surveyor's Michigan License No.

25849

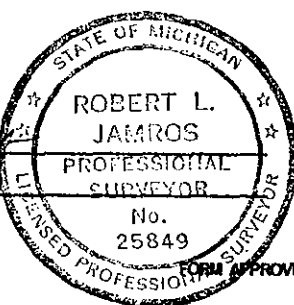

Date December 16, 1998

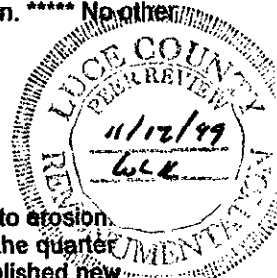

APPROVED BY MICHIGAN STATE BOARD OF PROFESSIONAL SURVEYORS, JAN. 26, 1971  
REVISED MAY 14, 1973  
REVISED JAN. 1983  
REVISED OCT. 1996

OTHER CODE: 1