 
MAR	1	7	3	(ÎI	OG
141. 117	Æ.		1	3.	1111

	THIND COUNTRY MECONDATION CERTIF
ECTION	Filing Requirement of Act 74, Mich. P.A

For corners in SECTION		uirement of Act 74, Mich		F	LEC	)			
LIVINGSTON (County)	Located In:	Corner Code #	0,	- '		,			
1. Public Land Survey	T1NR3E	F-7		1999 ИОУ	22   A	(10:1	37		
· · · · · · · · · · · · · · · · · · ·	TR TR TR			REGISTI LIVINGST	/ HAVIL ER OF D ON COUN	AND EEDS NTY, M	ı <b>.</b>		
2. Property Controlling S_ in Section S_	TR			£.	18843				
3. Miscellaneous S_ Property in Sec. S_	TR TR		R	LSC egister of D	: #107 eeds St		File I	Numt	er
4. Lot No, Recorded	Plat					•			
5. Private Claims			1 A	6 - 5	B F G	H - 3-	-2	K	1 -
I, <u>DARRELL D. HUGLES</u> , in a that under requirements of P.A. 74, Mich	field survey on <u>NOV</u>	/EMBER 3 , 1999 do he	reby state 4	7 8	9-	10	-11-	:	12-
were in conformance with regulations instructions of the United States Depart Court of Law and /or that the corner poi	and rules therefore as retrient of the Interior, Burea	required in the current manual au of Land Management or by a de	of survey 5 ecree of a 6	1817	16	—15—	14		   3
rules of the Michigan Board of Land Sur monumented, recovered, found as expre		ı Court of Law; established, re-es	stablished,	19 20	21	22	23		24-
NOTE: Not more than 2 corners, on this certificate.	all in the same town and	d range, may be recorded	9 — 10 —	-30 29-	28	27	26		25_



1825 Sylvester Sibley, Deputy Surveyor GLO: BLACK OAK 20" N51E 85 LINKS HICKORY 6" N89W 44 LINKS

\* ADDITIONAL HISTORICAL INFORMATION ON BACK OF SHEET

Description of corner evidence found and/or method applied in restoring or reestablishing corner:

FOUND P. K. NAIL IN CENTER LINE DEXTER TRAIL, 0.1' BELOW ASPHALT GRADE. NAIL ON OCCUPATION TO NORTH.

C. Description of monument for corner and accessories established to perpetuate locating the position of the corner.

F-7, T1N, R3E, UNADILLA, set corner with 3/4" x 36" iron pipe, affixed with 2" dia. Brass disk. Disk stamped "Livingston Co. Monumentation Corner, 19834" in road box and is accepted as a careful and faithful reestablishment of the position of the original corner.

259 DEGREES 87.92' SET NAIL/TAG N/S 36" MAPLE. 052 DEGREES 46.64' SET NAIL/TAG SE/S UTILITY POLE. 152 DEGREES 30.98' SET NAIL/TAG NE/S ELM CLUSTER. 035 DEGREES 47.91' SET NAIL/TAG W/S 24" MAPLE.

> P.A. 345 1990, APPROVED BY LIVINGSTON COUNTY PEER GROUP ON 9-15-99 CO. REP JED

UNADILLA TWP.

Signed by Audil Land	Date	NOVEMBER 3, 1999
Surveyor's Michigan License No. 19834		

REVISED OCT., 1995