

LAND CORNER RECORDATION CERTIFICATE
Filing Requirement of Act 74, Mich. P.A. 1970

For corners in

LIVINGSTON

(County)

Located In:

Corner Code #

1. Public Land Survey

T1N R 3E

M-4

2. Property Controlling
in Section

S

T R

3. Miscellaneous
Property in Sec.

S

T R

S

T R

S

T R

T R

T R

4. Lot No. _____, Recorded Plat _____

5. Private Claims _____

FILED

NANCY HAVILAND
REGISTER OF DEEDS
LIVINGSTON COUNTY, MI.
48843

1997 JUL 24 P 1:04

L.S.C. #676m

Register of Deeds Stamp & File Number

I, CHARLES E GARLOCK, in a field survey on JULY 14, 1997, do hereby state that under requirements of P.A. 74, Michigan P.A. of 1970, the corner points mentioned in lines 1 and 2 above were in conformance with regulations and rules therefore as required in the current manual of survey instructions of the United States Department of the Interior, Bureau of Land Management or by a decree of a Court of Law and/or that the corner points mentioned in lines 3, 4 and 5 above were in conformance with the rules of the Michigan Board of Land Surveyors or by a Decree of a Court of Law; established, re-established, monumented, recovered, found as expressed below:

NOTE: Not more than 2 corners, all in the same town and range, may be recorded on this certificate.

A. Description of original monument and accessories and/or subsequent restoration:

GLO SURVEY DATED APRIL 15, 1825 BY S SIBLEY DS AND NONE OF THE GLO WITNESSES REMAIN
GLO WITNESSES: SET POST IN PRAIRE-NO BEARING TREES.

ADDITIONAL DATA ON REAR OF SHEET

B. Description of corner evidence found and/or method applied in restoring or reestablishing corner:

FOUND DNR CONC. MON WITH DNR/MI BRASS CAP ON N-S FENCE LINE AT +0.4' SET BY DON BISSELL PS

**SURVEY &
REMONUMENTATION**

FEB 24 1998


SECTION

C. Description of monument for corner and accessories established to perpetuate locating the position of the corner:

M-4: E 1/4 COR. SEC. 12 T1N-R3E UNADILLA TWP. LIV. CO. MI; RETAINED 4" DIA CONC. MON AS
N44E-19.57'-SP & TAG N/S 12" APPLE
N65E-19.01'-SP & TAG N/S 14" APPLE
S85E-20.64'-SP & TAG N/S 16" APPLE
S59E-23.38'-SP & TAG N/S 12" APPLE
N58W-9.31'-SP AND TAG N/S 6" ELM
WEST-12'-E. EDGE OF ANDERSON DRAIN
FLOWING TO THE NORTH
NORTH-4.88'-PUTNAM TWP. COR.

Signed by Charles E Garlock
Surveyor's Michigan License No. 14762

Date JULY 14, 1997

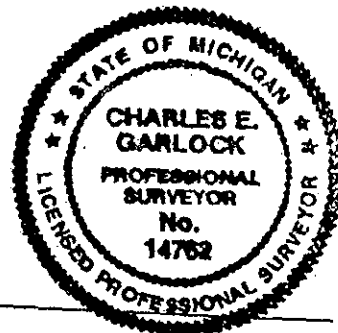

P.A. 345 1980, APPROVED BY LIVINGSTON COUNTY
PEER GROUP ON 4/2/97 CO. REP JED


FORM APPROVED BY MICHIGAN STATE BOARD OF PROFESSIONAL SURVEYORS, JAN. 28, 1971
REVISED MAY 14, 1975
REVISED JAN., 1983
REVISED OCT., 1995

CORNER SUMMARY

E 1/4 COR. SEC. 12, T1N-R3E, UNADILLA TWP. LIV. CO. MI

GLO SURVEY DATED 4/15/1825 BY S SIBLEY AND NONE OF THE GLO WITNESSES REMAIN.

IN 1975 BENTON SET AN IRON ROD IN A POST HOLE AND IN A FENCE LINE RUNNING NORTH-SOUTH FOR THE E 1/4 COR.; HE ALSO SET AN IRON ROD AT THE INTERSECTION OF FENCE LINES NORTH-SOUTH WITH A FENCE LINE TO THE EAST, FOR THE W 1/4 COR. SEC. 7 PUTNAM TWP. THE DISTANCE MEASURED BETWEEN THE TWO IRONS IS 4.88 FEET AND THE COMPUTED GLO JOG IS 4.95 FEET. IN 1987 D BISSELL OF THE MICHIGAN DNR REPLACED BENTONS IRON RODS WITH CONCRETE MONUMENTS (4" DIA. BY 36" LONG) AND A DNR BRASS CAP ON TOP. REMAINING WITNESSES BY BENTON AND BISSELL CHECK WITH THE FOUND CONCRETE MONUMENT WITH THE BRASS CAP. MEASURES SOUTH TO M-5 ARE 2647.06 BY BENTON, 2647.43 BY BISSELL AND WE HAD 2646.83 FEET. MEASURE NORTH TO M-3 IS 2633.58 FEET BY US FOR THE REMON THIS YEAR AND FOUND NO OTHER MEASURES TO COMPARE WITH. THE CORNER IS LOCATED ABOUT 12 FEET EAST OF THE EXISTING DRAIN RUNNING NORTH-SOUTH AND BECAUSE OF TREE COVER IT WOULD NOT BE A GOOD GPS SITE. RECOMMEND USING THE CORNER AS FOUND AND NOT REPLACING IT WITH OUR STANDARD 1 1/4" X 36" IRON PIPE WITH THE LIV. CO. REMON. BRASS CAP.

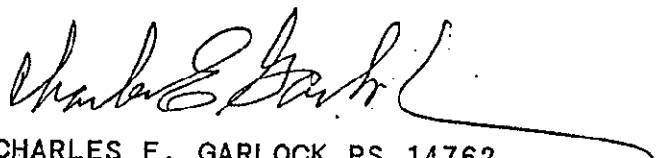

CHARLES E. GARLOCK PS 14762
UNA97M4

11/3 E
M4
4