

# SURVEY & REMONUMENTATION

FEB 26 2001

## SECTION

### LAND CORNER RECORDATION CERTIFICATE Filing Requirement of Act 74, Mich. P.A. 1970

9 FILED

For corners in

LIVINGSTON Located In: Corner Code #  
(County)  
1. Public Land Survey T 1 N R 4 E E-06  
T R  
T R  
T R  
2. Property Controlling S T R  
in Section S T R  
3. Miscellaneous S T R  
Property in Sec. S T R

2000 SEP 28 A 9:17

NANCY HAVILAND  
REGISTER OF DEEDS  
LIVINGSTON COUNTY, MI.  
48843

LSC #1271m

Register of Deeds Stamp & File Number

4. Lot No. \_\_\_\_\_, Recorded Plat \_\_\_\_\_  
5. Private Claims \_\_\_\_\_

I, JACK K. SMITH, in a field survey on AUGUST 25, 2000 do hereby state that under requirements of P.A. 74, Michigan P.A. of 1970, the corner points mentioned in lines 1 and 2 above were in conformance with regulations and rules therefore as required in the current manual of survey instructions of the United States Department of the Interior, Bureau of Land Management or by a decree of a Court of Law and/or that the corner points mentioned in lines 3, 4 and 5 above were in conformance with the rules of the Michigan Board of Land Surveyors or by a Decree of a Court of Law; established, re-established, monumented, recovered, found as expressed below:

NOTE: Not more than 2 corners, all in the same town and range, may be recorded on this certificate.

1	A	B	C	D	E	F	G	H	I	J	K	L	M
2		6		5		4		3		2		1	
3													
4		7		8		9		10		11		12	
5													
6		18		17		16		15		14		13	
7													
8		19		20		21		22		23		24	
9													
10		30		29		28		27		26		25	
11													
12		31		32		33		34		35		36	
13													

A. Description of original monument and accessories and/or subsequent restoration:

GLO 1825 JOSEPH WAMPLER SET POST  
BLACK OAK 8" S6°E 31.02'  
HICKORY 5" N7°W 38.28'


B. Description of corner evidence found and/or method applied in restoring or reestablishing corner:

THE EXISTING CORNER IS A 30" HICKORY APPROXIMATELY 4 FEET SOUTH OF A GOLF CART PATH WITH A FENCE LINE AND A TREE ROW RUNNING TO THE SOUTH AND EAST.

C. Description of monument for corner and accessories established to perpetuate locating the position of the corner:

E-06 WEST 1/4 CORNER SECTION 16, T1N, R4E, PUTNAM TOWNSHIP, LIVINGSTON COUNTY, MICHIGAN:  
SET 2 LIVINGSTON COUNTY REMONUMENTATION REFERENCE MONUMENTS OFFSET 3 FEET TO THE NORTHWEST AND SOUTHWEST OF THE CENTER OF THE EXISTING TREE.

N75°E SPIKE AND REMON TAG ON EAST SIDE OF 8" OAK 33.95'  
WEST SPIKE AND REMON TAG ON NORTH SIDE OF 22" HICKORY 46.10'  
SOUTH SPIKE AND REMON TAG ON EAST SIDE OF 4" OAK 35.20'  
N45°W 1" PIPE WITH BRASS REMON WITNESS CAP 3.00'  
S45°W 1" PIPE WITH BRASS REMON WITNESS CAP 3.00'

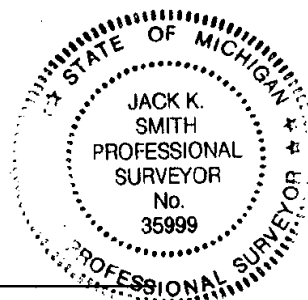

Signed by

*[Signature]*

Date

9-15-2000

PA. 345 1980, APPROVED BY LIVINGSTON COUNTY

PEER GROUP ON 2-2-2000 CO. REP JED

Surveyor's Michigan License No. 35999