

SURVEY &
REMONUMENTATION

FEB 26 2001

SECTION

LAND CORNER RECORDATION CERTIFICATE
Filing Requirement of Act 74, Mich. P.A. 1970

FILED

For corners in

LIVINGSTON

(County)

Located In:

Corner Code #

1. Public Land Survey

T 1 N R 4 E

E-09

T R

T R

T R

2. Property Controlling
in Section

S

T R

S

T R

3. Miscellaneous
Property in Sec.

S

T R

S

T R

2000 SEP 28 10 18

NANCY HAVILAND
REGISTER OF DEEDS
LIVINGSTON COUNTY, MI.
48843

LSC #1274m

Register of Deeds Stamp & File Number

4. Lot No. _____, Recorded Plat _____

5. Private Claims _____

I, JACK K. SMITH, in a field survey on AUGUST 25, 2000 do hereby state that under requirements of P.A. 74, Michigan P.A. of 1970, the corner points mentioned in lines 1 and 2 above were in conformance with regulations and rules therefore as required in the current manual of survey instructions of the United States Department of the Interior, Bureau of Land Management or by a decree of a Court of Law and/or that the corner points mentioned in lines 3, 4 and 5 above were in conformance with the rules of the Michigan Board of Land Surveyors or by a Decree of a Court of Law; established, re-established, monumented, recovered, found as expressed below:

NOTE: Not more than 2 corners, all in the same town and range, may be recorded on this certificate.

| A | B | C | D | E | F | G | H | I | J | K | L |
|----|----|---|----|---|----|---|----|---|----|---|----|
| 1 | | | | | | | | | | | |
| 2 | 6 | | 5 | | 4 | | 3 | | 2 | | 1 |
| 3 | | | | | | | | | | | |
| 4 | 7 | | 8 | | 9 | | 10 | | 11 | | 12 |
| 5 | | | | | | | | | | | |
| 6 | 18 | | 17 | | 16 | | 15 | | 14 | | 13 |
| 7 | | | | | | | | | | | |
| 8 | 19 | | 20 | | 21 | | 22 | | 23 | | 24 |
| 9 | | | | | | | | | | | |
| 10 | 30 | | 29 | | 28 | | 27 | | 26 | | 25 |
| 11 | | | | | | | | | | | |
| 12 | 31 | | 32 | | 33 | | 34 | | 35 | | 36 |
| 13 | | | | | | | | | | | |

A. Description of original monument and accessories and/or subsequent restoration:

GLO 1825 JOSEPH WAMPLER SET POST
BLACK OAK 19" S35°E 28.38'
WHITE OAK 18" S67°W 27.72'

B. Description of corner evidence found and/or method applied in restoring or reestablishing corner:

THE EXISTING CORNER IS A 20" OAK.

C. Description of monument for corner and accessories established to perpetuate locating the position of the corner:

E-09 SOUTHWEST CORNER SECTION 21, T1N, R4E, PUTNAM TOWNSHIP, LIVINGSTON COUNTY, MICHIGAN:
THE CORNER IS THE CENTER OF A 14" OAK TREE ON AN EAST-WEST FENCE LINE.


| | |
|---|--------|
| N45°E LIVINGSTON COUNTY REMON 1" STEEL WITNESS PIPE & BRASS CAP | 20.00' |
| N45°W LIVINGSTON COUNTY REMON 1" STEEL WITNESS PIPE & BRASS CAP | 20.00' |
| S45°E LIVINGSTON COUNTY REMON 1" STEEL WITNESS PIPE & BRASS CAP | 20.00' |
| S45°W LIVINGSTON COUNTY REMON 1" STEEL WITNESS PIPE & BRASS CAP | 20.00' |

Signed by

Date

9-15-2000

Surveyor's Michigan License No. 35999

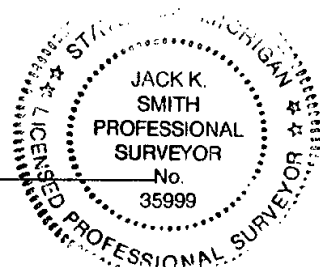

FORM APPROVED BY MICHIGAN STATE BOARD OF PROFESSIONAL SURVEYORS, JAN. 28, 1971

P.A. 345 1990, APPROVED BY LIVINGSTON COUNTY

REVISED MAY 14, 1975

REVISED JAN., 1983

REVISED OCT., 1995

2-2-2000 CO. REP JED