

SURVEY &
REMONUMENTATION

FEB 26 2001

SECTION

LAND CORNER RECORDATION CERTIFICATE
Filing Requirement of Act 74, Mich. P.A. 1970

FILED

For corners in

LIVINGSTON
(County)
1. Public Land Survey
2. Property Controlling
in Section
3. Miscellaneous
Property in Sec.
S
S
S
T
T
T
R
R
F-09

2000 SEP 28 1A 9:18

NANCY HAVILAND
REGISTER OF DEEDS
LIVINGSTON COUNTY, MI.
48843

LSC #1278m

Register of Deeds Stamp & File Number

4. Lot No. _____, Recorded Plat _____
5. Private Claims _____

I, JACK K. SMITH, in a field survey on AUGUST 25, 2000 do hereby state that under requirements of P.A. 74, Michigan P.A. of 1970, the corner points mentioned in lines 1 and 2 above were in conformance with regulations and rules therefore as required in the current manual of survey instructions of the United States Department of the Interior, Bureau of Land Management or by a decree of a Court of Law and /or that the corner points mentioned in lines 3, 4 and 5 above were in conformance with the rules of the Michigan Board of Land Surveyors or by a Decree of a Court of Law; established, re-established, monumented, recovered, found as expressed below:

NOTE: Not more than 2 corners, all in the same town and range, may be recorded on this certificate.

| 1 | A | B | C | D | E | F | G | H | I | J | K | L |
|----|---|----|---|----|---|----|---|----|---|----|---|----|
| 2 | | 6 | | 5 | | 4 | | 3 | | 2 | | 1 |
| 3 | | | | | | | | | | | | |
| 4 | | 7 | | 8 | | 9 | | 10 | | 11 | | 12 |
| 5 | | | | | | | | | | | | |
| 6 | | 18 | | 17 | | 16 | | 15 | | 14 | | 13 |
| 7 | | | | | | | | | | | | |
| 8 | | 19 | | 20 | | 21 | | 22 | | 23 | | 24 |
| 9 | | | | | | | | | | | | |
| 10 | | 30 | | 29 | | 28 | | 27 | | 26 | | 25 |
| 11 | | | | | | | | | | | | |
| 12 | | 31 | | 32 | | 33 | | 34 | | 35 | | 36 |
| 13 | | | | | | | | | | | | |

A. Description of original monument and accessories and/or subsequent restoration:

GLO 1825 JOSEPH WAMPLER SET POST
WHITE OAK 13" S60°W 15.18'
WHITE OAK 18" N51°W 35.64'


B. Description of corner evidence found and/or method applied in restoring or reestablishing corner:

THE EXISTING CORNER IS A CAPPED 1/2" REROD 1 FOOT BELOW THE SURROUNDING GROUND AT THE INTERSECTION OF FENCE REMAINS AND TREE ROWS NORTH, SOUTH, EAST AND WEST. THIS APPEARS TO BE THE ONLY CORNER USED SINCE AT LEAST 1979.

C. Description of monument for corner and accessories established to perpetuate locating the position of the corner:

F-09 SOUTH 1/4 CORNER SECTION 21, T1N, R4E, PUTNAM TOWNSHIP, LIVINGSTON COUNTY, MICHIGAN:
SET 1 1/4" x 36" STEEL PIPE WITH LIVINGSTON COUNTY REMONUMENTATION BRASS CAP STAMPED SURVEYOR #35999
PLACE OF 1/2" REROD.

S85°W SPIKE AND REMON TAG ON SOUTH SIDE OF 12" OAK 21.50'
N15°W SPIKE AND REMON TAG ON EAST SIDE OF 20" OAK 15.00'
N50°E SPIKE AND REMON TAG ON WEST SIDE OF 12" OAK 18.97'
S05°E SPIKE AND REMON TAG ON WEST SIDE OF 14" OAK 13.81'

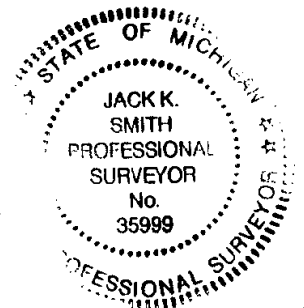

Signed by Jack K. Smith Date 9-15-2000

Surveyor's Michigan License No. 35999

P.A. 345 1980, APPROVED BY LIVINGSTON COUNTY
PEER GROUP ON 2-2-2000, CO. REP JE