

MAR 17 2000

FILED

SECTION

LAND CORNER RECORDATION CERTIFICATE
Filing Requirement of Act 74, Mich. P.A. 1970

1999 NOV 22 A 11:09

For corners in

LIVINGSTON

(County)

Located in: HAMBURG

Corner Code #

9

NANCY HAVILAND
REGISTER OF DEEDS
LIVINGSTON COUNTY, MI.
48843

1. Public Land Survey T 1N R 5E H-7
T R
T R
T R
2. Property Controlling S T R
in Section S T R
3. Miscellaneous S T R
Property in Sec. S T R

LSC# 1126m

Register of Deeds Stamp and File Number

4. Lot No. , Recorded Plat
5. Private Claims

I, Bryan L. Boss, in a field survey on NOV. 9, 1999

do hereby certify that under requirements of P.A. 74, Michigan P.A. of 1970, the corner points mentioned in lines 1 and 2 above were in conformance with regulations and rules therefor as required in the current manual of survey instructions of the United States Department of the Interior, Bureau of Land Management or by a decree of a Court of Law and/or that the corner points mentioned in lines 3,4 and 5 above were in conformance with the rules of the Michigan Board of Land Surveyors or by a Decree of a Court of Law; established, re-established, monumented, re-monumented, recovered, found as expressed below.

NOTE: Not more than 4 corners, all in the same town and range, may be recorded on this certificate.

A. Description of original monument and accessories and/or subsequent restoration:

- SET POST AT AVERAGE DISTANCE
- B. OAK 15" S83 1/2°W 80 LINKS
- B. OAK 16" N 26 1/2°E 66 LINKS

B. Description of corner evidence found and/or method applied in restoring or reestablishing corner:

- NO EVIDENCE FOUND OF CORNER.
- ESTABLISHED CORNER AT SINGLE PROPORTIONATE DISTANCE
- BETWEEN CORNERS G-7 AND I-7


C. Description of monument for corner and accessories established to perpetuate locating the position of the corner:

- SET 1 1/4" X 36" PIPE WITH BRASS CAP STAMPED
- "LIVINGSTON COUNTY REMONUMENTATION
- CORNER" IN LAKELAND COUNTRY CLUB GOLF
- COURSE
- NORTH 146.28' SET REMON NAIL/TAG W/S 20"
- MAPLE
- N45°W 93.27' SET REMON NAIL/TAG W/S 24"
- WHITE PINE
- WEST 135.15' SET REMON NAIL/TAG S/S 24"
- SCOTCH PINE
- S45°E 108.10' SET REMON NAIL/TAG SW/S 18"
- MAPLE
- N45°W 8.28' CENTER OF "IRRIGATION CONTROL
- VALVE" "CARSON INDUSTRIES"
- SOUTH 21.63' CENTER OF SPRINKLER HEAD
- CORNER IS 26 FEET NORTH OF SOUTH EDGE OF
- FAIRWAY

	A	B	C	D	E	F	G	H	I	J	K	L	M
2	6	5	4	3	2	1							
3													
4	7	8	9	10	11	12							
5													
6	18	17	16	15	14	13							
7													
8	19	20	21	22	23	24							
9													
10	30	29	28	27	26	25							
11													
12	31	32	33	34	35	36							
13													

P.A. 345 1990, APPROVED BY LIVINGSTON COUNTY

PEER GROUP ON 9-15-99 CO. REP JED

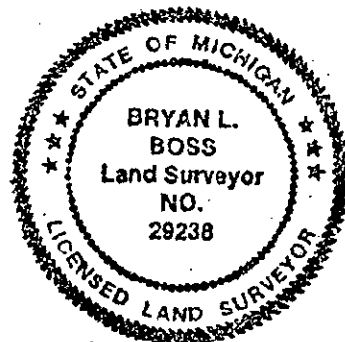

Signed by Bryan L. Boss

Date NOV. 11, 1999

Surveyor's Michigan License No. 29238