

FEB 25 1999

SECTION

FILED

LAND CORNER RECORDATION CERTIFICATE
Filing Requirement of Act 74, Mich. P.A. 1970

1998 OCT 27 P 2:22

For corners in

Livingston
(County)

Located in

Corner Code //

NANCY HAVILAND
REGISTER OF DEEDS
LIVINGSTON COUNTY, MI.
48843

1. Public Land Survey

T 1N R 5E

I-9

2. Property Controlling
in Section

S T R

3. Miscellaneous

S T R

Property in Sec.

S T R

1sc963M

Register of Deeds Stamp & File Number

4. Lot No. , Recorded Plat

5. Private Claims

	A	B	C	D	E	F	G	H	I	J	K	L	M
2	6	5	4	3	2								
3													
4	7	8	9	10	11	12							
5													
6	13	17	16	15	14	13							
7													
8	19	20	21	22	23	24							
9													
10	30	29	28	27	26	25							
11													
12	31	32	33	34	35	36							
13													

Bryan L. Boss, in a field survey on October 2, 1998,
to hereby certify that under requirements of P.A. 74, Michigan P.A. of 1970, the corner points mentioned
in lines 1 and 2 above were in conformance with regulations and rules therefore as required in the
current manual of survey instructions of the United States Department of the Interior, Bureau of Land
Management or by a decree of a Court of Law and/or that the corner points mentioned in lines 3, 4 and 5
above were in conformance with the rules of the Michigan Board of Land Surveyors or by a Decree of a
Court of Law; established, re-established, monumented, re-monumented, recovered, found as
expressed below:

NOTE: Not more than 4 corners, all in the same town and range, may be recorded
on this certificate.

6. Description of original monument and accessories and/or subsequent restoration:

Set Post 1823

Black Oak 12" S 26½ W 8 links

White Oak 8" S 81½ W 66 links

7. Description of corner evidence found and/or method applied in restoring or reestablishing corner:

Found 3/4" Iron Rod W/1½ Square head in Firebrick monument

PA. 345 1980, APPROVED BY LIVINGSTON COUNTY
PEER GROUP ON 9-30-98 CO. REP JED

8. Description of monument for corner and accessories established to perpetuate locating the position of the corner:


Cut off 1½" Square Head & Set 1½ by 6" Pipe in concrete
Placed Brass Cap Stamped "Livingston County Remonumentation
Corner

N 30 W 7.48' N/T NE/S 16" Oak

N 10 E 21.04 N/T E/S 14" Oak

East 30.59 N/T S/S 15" Oak

S 40. E 32.05 N/T N/S 18" Oak

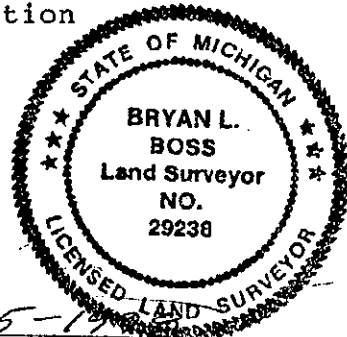

Signed by Bryan L. Boss

Date 10-15-1998

Surveyor's Michigan License No. 29238