

# SURVEY & REMONUMENTATION

FEB 25 1999

FILED

## SECTION

## LAND CORNER RECORDATION CERTIFICATE Filing Requirement of Act 74, Mich. P.A. 1970

For corners in

Livingston  
(County)

Located In:

Corner Code //

1998 OCT 27 P 2: 22

NANCY HAVILAND  
REGISTER OF DEEDS  
LIVINGSTON COUNTY, MI.  
48843

LSC966M

Register of Deeds Stamp & File Number

- |                                    |   |           |   |           |            |
|------------------------------------|---|-----------|---|-----------|------------|
| 1. Public Land Survey              | T | <u>1N</u> | R | <u>5E</u> | <u>J-7</u> |
|                                    | T |           | R |           |            |
|                                    | T |           | R |           |            |
|                                    | T |           | R |           |            |
| 2. Property Controlling in Section | S |           | T | R         |            |
|                                    | S |           | T | R         |            |
| 3. Miscellaneous                   | S |           | T | R         |            |
| Property in Sec.                   | S |           | T | R         |            |

4. Lot No. \_\_\_\_\_, Recorded Plat \_\_\_\_\_
5. Private Claims \_\_\_\_\_

I, Bryan L. Boss, in a field survey on Oct. 2, 19 98, do hereby certify that under requirements of P.A. 74, Michigan P.A. of 1970, the corner points mentioned in lines 1 and 2 above were in conformance with regulations and rules therefore as required in the current manual of survey instructions of the United States Department of the Interior, Bureau of Land Management or by a decree of a Court of Law and/or that the corner points mentioned in lines 3, 4 and 5 above were in conformance with the rules of the Michigan Board of Land Surveyors or by a Decree of a Court of Law; established, re-established, monumented, re-monumented, recovered, found as expressed below:

NOTE: Not more than 4 corners, all in the same town and range, may be recorded on this certificate.

A. Description of original monument and accessories and/or subsequent restoration:

Set post by Wampler in 1823  
Black Oak 13" S 44 W 90 links  
White Oak 12 S 58 W 84 links


B. Description of corner evidence found and/or method applied in restoring or reestablishing corner:

Found  $\frac{1}{2}$ " iron rod  
To reach corner measure 320 from power pole Southwest toward  
36" Hickory then measure 70' Southeast at right angles to point

PA. 345 1990, APPROVED BY LIVINGSTON COUNTY  
PEER GROUP ON 9.30.98 CO. REP JED

C. Description of monument for corner and accessories established to perpetuate locating the position of the corner:

Set  $1\frac{1}{4}$ " by 30" iron pipe with plastic breakaway and  $1\frac{1}{4}$ " by 6" iron pipe with Brass cap stamped "Livingston County Monumentation Corner"  
East 820.07 Found concrete monument  
West 351.59 found  $\frac{1}{2}$ " iron rod near fence corner post  
S 70 W 301.41 Set Remon N/T NW/S 36" Hickory  
S 8 E 547.59 Set Remon N/T E/S 55" Oak  
N 48 E 328.16 Set Remon N/T W/S power pole with transformer  
N 20 W 348.05 Set Remon N/T SW/S 20" Oak

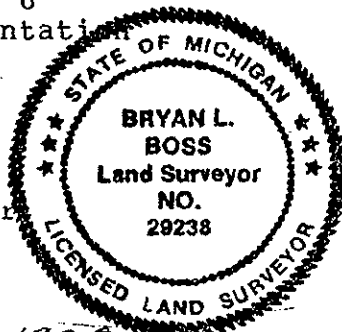

Signed by Bryan L. Boss Date 10-15-1998  
Surveyor's Michigan License No. 29238