

OCT 26 1995

COMMISSION

LAND CORNER RECORDATION CERTIFICATE
Filing Requirement of Act 74, Mich. P.A. 1970

For corners in

Livingston
(County)

Located In:

Corner Code ##

- | | | |
|------------------------------------|-------------------------|------------|
| 1. Public Land Survey | T <u>1N</u> R <u>5E</u> | <u>M-7</u> |
| | T _____ R _____ | _____ |
| | T _____ R _____ | _____ |
| | T _____ R _____ | _____ |
| 2. Property Controlling in Section | S _____ T _____ R _____ | _____ |
| | S _____ T _____ R _____ | _____ |
| 3. Miscellaneous Property in Sec. | S _____ T _____ R _____ | _____ |
| | S _____ T _____ R _____ | _____ |

4. Lot No. _____, Recorded Plat _____
5. Private Claims _____

I, Bryan Boss, in a field survey on 9-25, 19 95, do hereby certify that under requirements of P.A. 74, Michigan P.A. of 1970, the corner points mentioned in lines 1 and 2 above were in conformance with regulations and rules therefore as required in the current manual of survey instructions of the United States Department of the Interior, Bureau of Land Management or by a decree of a Court of Law and/or that the corner points mentioned in lines 3, 4 and 5 above were in conformance with the rules of the Michigan Board of Land Surveyors or by a Decree of a Court of Law; established, re-established, monumented, re-monumented, recovered, found as expressed below:

NOTE: Not more than 4 corners, all in the same town and range, may be recorded on this certificate.

A. Description of original monument and accessories and/or subsequent restoration:

White Oak 36" S 3° W 1.25
Black Oak 5" N 75° E 32 links
Hickory 14" S 50° W 17 links
Yellow Oak 12" N 8° W 27.7 links
4" x 36" Oak stake set in 1923 by Grant Dunning

B. Description of corner evidence found and/or method applied in restoring or reestablishing corner:

Found $\frac{1}{2}$ inch rebar 2 feet +/- West of fence.
Plat monument North 733.84 feet
Northwest corner Section 19, T1N-R6E
Green Oak Township/concrete monument 563.21 feet
Southeast Corner, Lot 66, Riverbendwillow Sub. No. 2
Liber 6, Page 10, Monument 251.56 feet.

C. Description of monument for corner and accessories established to perpetuate locating the position of the corner:

Set brass cap in 36" pipe at surface grade.
41.12' N 80° E nail & tag South side 8" Oak
35.43' S 80° E nail & tag South side 6" Oak
39.05' South nail & tag East side 26" Oak
7.83' N 30° W nail & tag Northeast side 26" Hickory

OCT 4 3 19 PM '95
NANCY HAVILAH,
REGISTER OF DEEDS
LIVINGSTON COUNTY, MI
48843

L.S.C. #453m


Register of Deeds Stamp & File Number

	A	B	C	D	E	F	G	H	I	J	K	L	M
2	6	5	4	3	2	1							
3													
4	7	6	5	4	3	2	1						
5													
6	18	17	16	15	14	13							
7													
8	19	20	21	22	23	24							
9													
10	30	29	28	27	26	25							
11													
12	31	32	33	34	35	36							
13													

Signed by Bryan L. Boss

Date Sept. 28, 1995

Surveyor's Michigan License No. 29238

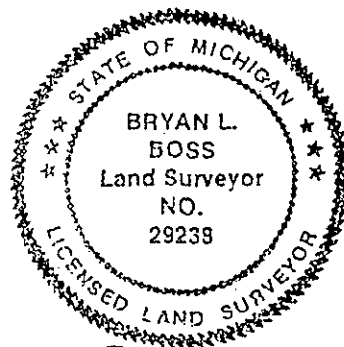


SUMMARY
M-7

NORTHEAST CORNER, SECTION 24, T1N-R5E HAMBURG TOWNSHIP,
LIVINGSTON COUNTY, MICHIGAN.

Found $\frac{1}{2}$ " inch rerod (no cap) 2 feet \pm West of new fence and in tree row North and South. Government Land Office notes and map, call for 8.75 chains (577.5 feet) South to Northwest corner Section 19, T1N-R6E, Green Oak Township. Boss Engineering measures 563.21 feet and H.C.M.A. Measures 563.59 feet to same Section 19 corner. (A found concrete monument). Also found monument at Northeast corner of "Riverbendwillo Subdivision No. 2" platted on 7-14-54 by McMahon Engineering. Measured recorded distance of 483.06 Southerly along East line of Section 13 and found Boss iron at S.E. corner Lot 66 of said plat. Continued South to Section corner and measured recorded distance of 251.56 feet to found $\frac{1}{2}$ " inch rerod.

Conclusion: We find the $\frac{1}{2}$ " inch rerod as found in North-South tree row, to be at the same location found by McMahon Engineering in 1954. And accept as Northeast corner Section 24.

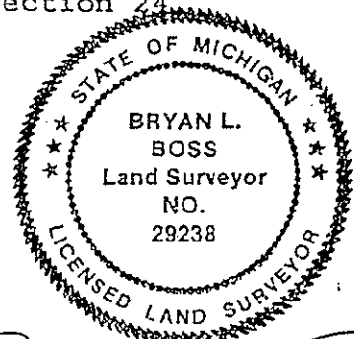

SUMMM-7

A handwritten signature in cursive script, appearing to read "Bryan L. Boss", written in dark ink.