

MAR 17 2000

**FILED**

**SECTION**

**LAND CORNER RECORDATION CERTIFICATE  
Filing Requirement of Act 74, Mich. P.A. 1970**

1999 NOV 22 A 11:09

For corners in  
LIVINGSTON  
(County)

Located in: HAMBURG Corner Code #

NANCY HAVILAND  
REGISTER OF DEEDS  
LIVINGSTON COUNTY, MI.  
48843

1. Public Land Survey T 1N R 5E F-9  
T R  
T R  
T R  
2. Property Controlling S T R  
In Section S T R  
3. Miscellaneous S 21 T 1N R 5E 009  
Property in Sec. S 21 T 1N R 5E 010 ✓

LSC# 1118m

Register of Deeds Stamp and File Number

4. Lot No. , Recorded Plat  
5. Private Claims

I, Bryan L. Boss, in a field survey on 10-28-99  
do hereby certify that under requirements of P.A. 74, Michigan P.A. of 1970, the corner points mentioned in lines 1 and 2 above were in conformance with regulations and rules therefor as required in the current manual of survey instructions of the United States Department of the Interior, Bureau of Land Management or by a decree of a Court of Law and/or that the corner points mentioned in lines 3, 4 and 5 above were in conformance with the rules of the Michigan Board of Land Surveyors or by a Decree of a Court of Law; established, re-established, monumented, re-monumented, recovered, found as expressed below.

NOTE: Not more than 4 corners, all in the same town and range, may be recorded on this certificate.

A. Description of original monument and accessories and/or subsequent restoration:

CORNER WAS NOT SET BECAUSE IT IS IN BASS LAKE

B. Description of corner evidence found and/or method applied in restoring or reestablishing corner:

LOCATION FOR CORNER WAS ESTABLISHED AT A POINT IN BASS LAKE, 216.15 FEET WEST OF THE FOUND CONCRETE MONUMENT AT THE NW COR. OF OUTLOT B OF "CAMPBELL SUBDIVISION" L.7, PG.1 L.C.R. ALONG THE NORTH LINE OF THE SUBDIVISION AS MONUMENTED. THIS LOCATION IS CONSISTENT WITH PREVIOUS

REFERENCE POINT 1 (009)  
THIS POINT IS THE CONCRETE MONUMENT AT THE NORTHWEST CORNER OF OUTLOT B OF CAMPBELL SUBDIVISION 216.15 EAST OF THE CORNER F-9

CORNER F-9 TO REF. PT. 1 N86°37'51"E, 216.15'  
CORNER F-9 TO REF. PT. 2 N28°48'22"W, 786.95'  
REF. PT. 1 TO REF. PT. 2 N41°18'22"W 901.37'


REFERENCE POINT 2 (010)  
THIS IS A 1 1/4" X 36" PIPE SET AT THE LOCATION OF A FOUND 1/2" IRON ROD 10 FT. NORTH OF THE NORTH SHORE OF BASS LAKE ON THE APPARENT LOT LINE BETWEEN HOUSES #9800 AND #9810 BLUEWATER DRIVE

C. Description of monument for corner and accessories established to perpetuate locating the position of the corner:

REFERENCE POINT 1 - 009  
SET BRASS CAP STAMPED "LIVINGSTON COUNTY REMONUMENTATION WITH" ON TOP OF AN EXISTING CONCRETE MONUMENT  
N10°E 55.33' SET REMON NAIL & TAG W/S 14" ASH  
N45°E 67.68' SET REMON NAIL & TAG SE/S 14" BLUE SPRUCE  
EAST 114.85' SET REMON NAIL & TAG N/S 24" COTTONWOOD  
S20°E 2.29' SET REMON NAIL & TAG E/S 28" COTTONWOOD

REFERENCE POINT 2 - 010  
SET 1 1/4" X 36" PIPE WITH BRASS CAP STAMPED "LIVINGSTON COUNTY REMONUMENTATION WITNESS"  
N80°W 46.60' SET REMON NAIL & TAG N/S 30" WILLOW  
N50°W 98.68' SW COR. STONE FACE OF HOUSE #9790  
N20°E 57.44' SW COR. VINYL SIDING HSE #9810  
EAST 64.77' SET NAIL & TAG N/S 48" WILLOW

P.A. 345 1990, APPROVED BY LIVINGSTON COUNTY  
PEER GROUP ON 9-1-99 CO. REP. JEO

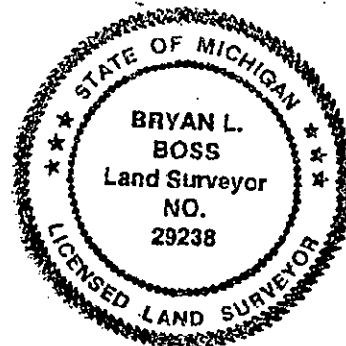

Signed by Bryan L. Boss

Date NOV. 9, 1999

Surveyor's Michigan License No. 29238