

SURVEY & REMONUMENTATION

FEB 26 2001

LAND CORNER RECORDATION CERTIFICATE Filing Requirement of Act 74, Mich. P.A. 1970

FILED

SECTION

For corners in
LIVINGSTON

(County)

Located in: HAMBURG

Corner Code #

2000 OCT 19 A 10:32

NANCY HAVILAND
REGISTER OF DEEDS
LIVINGSTON COUNTY, MI.
48843

1. Public Land Survey

T 1N R 5E

C-8

T R

T R

T R

T R

2. Property Controlling
in Section

S

T R

S

T R

3. Miscellaneous
Property in Sec.

S

T R


S

T R

LSC #1310m
Register of Deeds Stamp and File Number

4. Lot No. , Recorded Plat

5. Private Claims

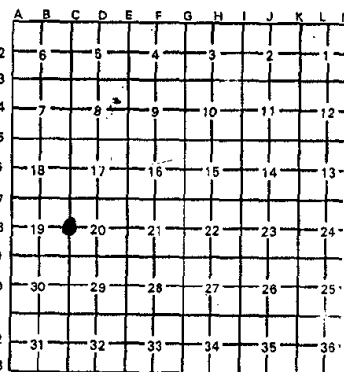

I, Bryan L. Boss, in a field survey on MARCH 23, 2000

do hereby certify that under requirements of P.A. 74, Michigan P.A. of 1970, the corner points mentioned in lines 1 and 2 above were in conformance with regulations and rules therefor as required in the current manual of survey instructions of the United States Department of the Interior, Bureau of Land Management or by a decree of a Court of Law and/or that the corner points mentioned in lines 3, 4 and 5 above were in conformance with the rules of the Michigan Board of Land Surveyors or by a Decree of a Court of Law; established, re-established, monumented, re-monumented, recovered, found as expressed below.

NOTE: Not more than 4 corners, all in the same town and range, may be recorded on this certificate.

A. Description of original monument and accessories and/or subsequent restoration:

1823 BY S. SIBLEY, DEPUTY SURVEYOR

SET POST

B. OAK 5" S 72°E 1.41 CHAINS

B. OAK 9" N 73°W 0.82 CHAINS

B. Description of corner evidence found and/or method applied in restoring or reestablishing corner:

FOUND 1/2" BOSS IRON IN MONUMENT BOX IN CENTER LINE M-36

C. Description of monument for corner and accessories established to perpetuate locating the position of the corner:

SET 1 1/4" X 30" STEEL PIPE & 6' X 1 1/4"

BREAKAWAY STEEL PIPE WITH A BRASS CAP

STAMPED "LIVINGSTON COUNTY

REMONUMENTATION CORNER" IN EXISTING

MONUMENT BOX

NORTH 30.45' SET REMON NAIL TAG E/SIDE


P. POLE

N 45°E 99.08' SET REMON NAIL TAG W/SIDE 15"

POPLAR

S 5°E 27.73' SET REMON NAIL TAG E/SIDE 24" OAK

N 80°W 172.43' SET REMON NAIL TAG S/SIDE
P. POLE

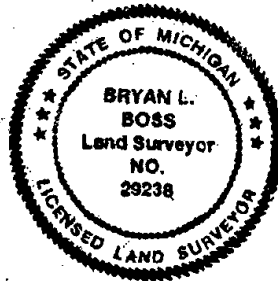

Signed by

Bryan L. Boss

Date

Sept. 5, 2000

Surveyor's Michigan License No.

29238

P.A. 345 1990, APPROVED BY LIVINGSTON COUNTY

PEER GROUP ON 2-2-2000 CO. REP JED

FORM APPROVED BY MICHIGAN STATE BOARD OF LAND SURVEYORS
REVISED MAY 14, 1
REVISED JAN. 1