

SURVEY &  
REMONUMENTATION

FILED

APR 28 1995 LAND CORNER RECORDATION CERTIFICATE  
Filing Requirement of Act 74, Mich. P.A. 1970

Nov 16 11 02 AM '94

COMMISSION

NANCY HAVILAND  
REGISTER OF DEEDS  
LIVINGSTON COUNTY, MI  
48843

or corners in

Livingston  
(County)

Located In:

Corner Code --#

Public Land Survey

T 1N R 6E

G-12

Property Controlling  
in Section

S T R

Miscellaneous

S T R

Property in Sec.

S T R

L.S.C. #305m

Register of Deeds Stamp & File Number

Lot No. , Recorded Plat

Private Claims

	A	B	C	D	E	F	G	H	I	J	K	L	M
2	6	5	4	3	2	1							
3													
4	7	8	9	10	11	12							
5													
6	18	17	16	15	14	13							
7													
8	19	20	21	22	23	24							
9													
10	30	29	28	27	26	25							
11													
12	31	32	33	34	35	36							
13													

H.L. O'Donnell, in a field survey on August 26, 1994, hereby certify that under requirements of P.A. 74, Michigan P.A. of 1970, the corner points mentioned in lines 1 and 2 above were in conformance with regulations and rules therefore as required in the current manual of survey instructions of the United States Department of the Interior, Bureau of Land Management or by a decree of a Court of Law and/or that the corner points mentioned in lines 3, 4 and 5 above were in conformance with the rules of the Michigan Board of Land Surveyors or by a Decree of a Court of Law; established, re-established, monumented, re-monumented, recovered, found as expressed below:

NOTE: Not more than 4 corners, all in the same town and range, may be recorded on this certificate.

Description of original monument and accessories and/or subsequent restoration:

GLO notes dated: 12/14/1815

GLO witnesses: W. Oak 22 in. dia. bears S55 E 57 lks

Do. 24 in. dia. bears N58 W 27 lks

Corner Summary on reverse side

Description of corner evidence found and/or method applied in restoring or reestablishing corner:

Found 3/8" iron rod

F. nail N. face 20" Ash N70°W 20.38'

F. nail E. face 24" Ash N10°W 57.79'

F. nail E. face 12" Ash S10°W 76.84'

F. nail N. face 12" Ash N80°W 51.91'

Description of monument for corner and accessories established to perpetuate locating the position of the corner:

G-12, E 1/4 cor. Sec. 33, T1N, R6E, Green Oak Township

Set 1 1/2" x 36" break away iron pipe with L.C.M. brass cap PS# 28149


Set flasher E. face 12" Ash S10°W 76.84'

Set flasher E. face 24" Ash N10°W 57.79'

Set flasher N. face 20" Ash N70°W 20.38'

Set flasher N. face 12" Ash N80°W 51.91'

Approved by Livingston County Monumentation Peer Group August 10, 1994

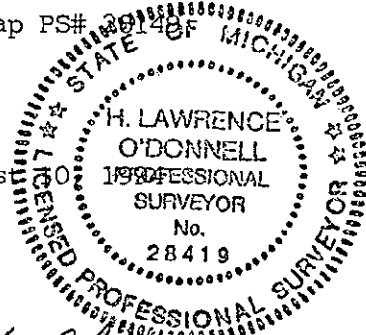

Signed by H. Lawrence O'Donnell  
Surveyor's Michigan License No. 28149

Date 11-1-94

FORM APPROVED BY MICHIGAN STATE BOARD OF LAND SURVEYORS, JAN. 28, 1971  
REVISED MAY 14, 1975  
REVISED JAN., 1983

P.A. 345 1990, APPROVED BY LIVINGSTON COUNTY  
PEER GROUP ON 10 Aug 94 CO. REP RAL

CELE

CORNER SUMMARY

G-12, E 1/4 corner, Section 33  
Green Oak Township, Livingston County

The oldest known witness is by Atwell-Hicks, Inc. in 1914 where only one witness was recorded and gives no reference to what was found. The corner was later witnessed by Atwell-Hicks, Inc. in 1958, by Jekabson in 1974, by Newton in 1974, by Roskelly-Jekabson in 1978 and 1985, by Mich. Eng. & Surv. Group in 1990, by Ambit in 1992 and by Roskelly-Jekabson in 1992 and 1993.

Atwell-Hicks, Inc. found a 3/8" iron rod in 1994 which agrees well with one witness taken in 1958. No other irons were found after a search of the area.

I recommend that this found iron rod be accepted as the E 1/4 corner of Section 33 of Green Oak Township.

  
H. Lawrence O'Donnell