

SURVEY &
REMONUMENTATION

FEB 24 1998

LAND CORNER RECORDATION CERTIFICATE
Filing Requirement of Act 74, Mich. P.A. 1970

FILED

SECTION

For corners in

LIVINGSTON

(County)

Located In:

Corner Code #

1. Public Land Survey

T 2N R 4E G-13

T R

T R

T R

T R

2. Property Controlling
in Section

S T R

S T R

3. Miscellaneous
Property in Sec.

S T R

S T R

1997 AUG 19 A 10:03

NANCY HAVILAND
REGISTER OF DEEDS
LIVINGSTON COUNTY, MI.
48843

L.S.C. #688m

Register of Deeds Stamp & File Number

4. Lot No. , Recorded Plat

5. Private Claims

I, CHARLES E GARLOCK, in a field survey on AUGUST 9 1997 do hereby state that under requirements of P.A. 74, Michigan P.A. of 1970, the corner points mentioned in lines 1 and 2 above were in conformance with regulations and rules therefore as required in the current manual of survey instructions of the United States Department of the Interior, Bureau of Land Management or by a decree of a Court of Law and/or that the corner points mentioned in lines 3, 4 and 5 above were in conformance with the rules of the Michigan Board of Land Surveyors or by a Decree of a Court of Law; established, re-established, monumented, recovered, found as expressed below:

NOTE: Not more than 2 corners, all in the same town and range, may be recorded on this certificate.

A. Description of original monument and accessories and/or subsequent restoration:

GLO SURVEY DATED APRIL 15, 1825 BY S SIBLEY AND NONE OF THE GLO WITNESSES REMAIN.

GLO WITNESSES: BO 9"-N45E-31LKS

BO 5"-N22W-42LKS

B. Description of corner evidence found and/or method applied in restoring or reestablishing corner:

FOUND 1/2" I. ROD C/L'S SCHAFER AND BENTLEY LAKE RDS. AS PER WITNESS BY GH DUNNING IN 1912


C. Description of monument for corner and accessories established to perpetuate locating the position of the corner:

G-13: SE COR. SEC. 33 T2N-R4E, MARION TWP. LIV. CO. MI. RESET FOUND POINT WITH 1 1/4" X 36" BREAKAWAY IRON PIPE WITH LIV. CO REMON BRASS CAP ON TOP, IN MON. BOX AT -0.5'
N49E-137.87'-SW COR. OF GARAGE
S62E-77.05'-SP & TAG N/S 30" OAK
S36E-65.50'-SP & TAG W/S 26" OAK
S42W-104.04'-NW COR. HOUSE
N39W-108.90'-SE COR. HOUSE
EAST-4'-C/L BENTLEY LAKE ROAD TO NORTH
ON C/L OF SCHAER ROAD

Signed by Charles E. Garlock

Surveyor's Michigan License No. 14762

Date AUGUST 10, 1997

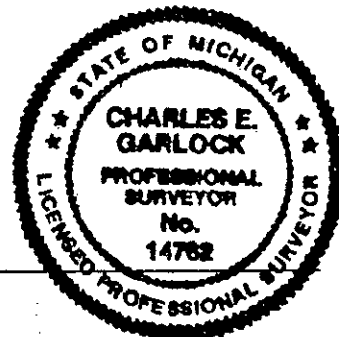

*"Be Sure of Your Ground"***CHARLES E. GARLOCK**


PROFESSIONAL SURVEYOR

705 N. MICHIGAN AVE.

HOWELL, MICHIGAN 48843

OFFICE: (517) 546-3340

FAX: 517 546-2941

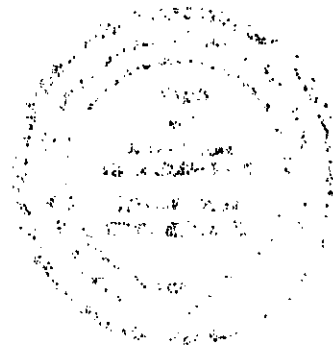

FEBRUARY 19, 1997

CORNER SUMMARY

G-13: SW COR. SEC. 34 T2N-R4E, MARION TWP. LIV. CO. MI

GLO SURVEY DATED APRIL 15, 1825 BY S SIBLEY AND NONE OF THE GLO WITNESSES REMAIN.

BULLOCKS TWO 1902 WITNESSES ARE GONE. DUNNING HAD FOUR WITNESSES IN 1912 AND ONE REMAINS AND CHECKS WITH A 1/2" IRON ROD WE FOUND ON THE EXISTING CENTERLINES OF BENTLEY LAKE AND SCHAFER ROADS AT -0.3'. REMAINING WITNESSES BY BENTON, MUNSELL '62 AND GARLOCK '69, '71, '73, '83 AND '88 CHECK TO THE SAME FOUND 1/2" IRON ROD. WE FOUND G-1 PUTNAM TWP. LOCATED 22.00' EAST AND ON THE TWP. LINE, GLO JOG AGAIN CALLS FOR THE CORNER TO BE 31.02' WEST OF G-13., MEASURES WEST ARE: 2651.88 OLD RECORDS, 2650.56 = DUNNING '12, 2650.40 = BENTON '68, 2650.46 = BENTON '77, 2650.04 = BOSS '87 & '91, 2650.02 = GARLOCK '96 AND WE HAD 2650.03 IN '97. MEASURES EAST ARE: 2650.89 = DUNNING '12, 2652.51 = MUNSELL '63 AND NEWTON '71, 2652.05 = GARLOCK '83 2652.38 = GARLOCK '88 AND WE HAD 2651.94 IN '97. CORNER IS GOOD FOR GPS. WE RECOMMEND G-13 AS FOUND TO BE USED AS THE REMON. CORNER.

CHARLES E GARLOCK

PS 14762

MAR97G13

SUCCESSOR TO:

MILES W. BULLOCK, L.S. (1844 TO 1928)



GRANT H DUNNING, P.E. (1885 TO 1928)

CLAY W. GORDON, RLS (1883 TO 1970)



LYLE W. MUNSELL, RLS (1904 TO 1987)

2N4E
G-13
4