

SURVEY & REMONUMENTATION

FEB 25 1999

SECTION

LAND CORNER RECORDATION CERTIFICATE Filing Requirement of Act 74, Mich. P.A. 1970

FILED

For corners in

LIVINGSTON
(County)

Located In:

Corner Code #

1. Public Land Survey

T2N R 4E J9

2. Property Controlling
in Section

S T R

3. Miscellaneous
Property in Sec.

S T R

4. Lot No. , Recorded Plat

5. Private Claims

CHARLES E GARLOCK

I, CHARLES E GARLOCK, in a field survey on AUG 11, 1998 do hereby state that under requirements of P.A. 74, Michigan P.A. of 1970, the corner points mentioned in lines 1 and 2 above were in conformance with regulations and rules therefore as required in the current manual of survey instructions of the United States Department of the Interior, Bureau of Land Management or by a decree of a Court of Law and/or that the corner points mentioned in lines 3, 4 and 5 above were in conformance with the rules of the Michigan Board of Land Surveyors or by a Decree of a Court of Law; established, re-established, monumented, recovered, found as expressed below:

NOTE: Not more than 2 corners, all in the same town and range, may be recorded on this certificate.


A. Description of original monument and accessories and/or subsequent restoration:

GLO SURVEY DATED APRIL 15, 1825 BY S SIBLEY

GLO WITNESSES: W020-N77E-23 LKS

W026-S81W-40 LKS

1	A	B	C	D	E	F	G	H	I	J	K	L	M
2	6		5		4		3		2		1		
3													
4	7		8		9		10		11		12		
5													
6	18		17		16		15		14		13		
7													
8	19		20		21		22		23		24		
9													
10	30		29		28		27		26		25		
11													
12	31		32		33		34		35		36		
13													

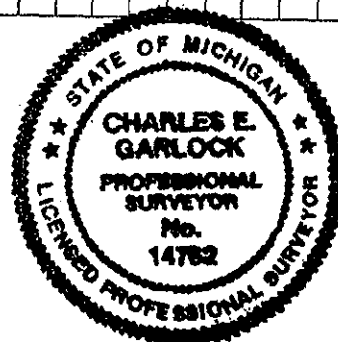

B. Description of corner evidence found and/or method applied in restoring or reestablishing corner:

FOUND 1/2" I. ROD W/CAP, 2 FT. NORTH OF CENTERLINE OF COON LAKE RD. IN ASPHALT FENCE LINES TO THE NORTH AND SOUTH. FOUND PK SPIKE UNDER SEAL COAT 1.5 FT WEST AND 1.0 FT. SOUTH OF 1/2" I. ROD. 1/2" I. ROD PROVED TO BE CORRECT CORNER.

C. Description of monument for corner and accessories established to perpetuate locating the position of the corner:

J9: S 1/4 COR. SEC. 23, T2N-R4E, MARION TWP. LIV. CO. MI, REPLACED 1/2" I. ROD WITH MON BOX AND 1 1/4" X 36" BREAKAWAY I. PIPE WITH LIV. CO. REMON BRASS CAP ON TOP.
NORTH-46.34'-SP & TAG E/S 8" HICKORY
S35W-42.80'-SP & TAG W/S 6" HICKORY
S63W-62.34'-SP & TAG W/S 10" CHERRY
SOUTH-34.30'-NW COR. OF ANGLE IRON, STEEL FENCE POST

Signed by

Charles E. Garlock

Date AUGUST 12, 1998

Surveyor's Michigan License No. 14762

PA. 345 1980, APPROVED BY LIVINGSTON COUNTY
PEER GROUP ON 5/20/98 CO. REP JED

FORM APPROVED BY MICHIGAN STATE BOARD OF PROFESSIONAL SURVEYORS, JAN. 28, 1971
REVISED MAY 14, 1975
REVISED JAN., 1983
REVISED OCT., 1995